MICROFILMED

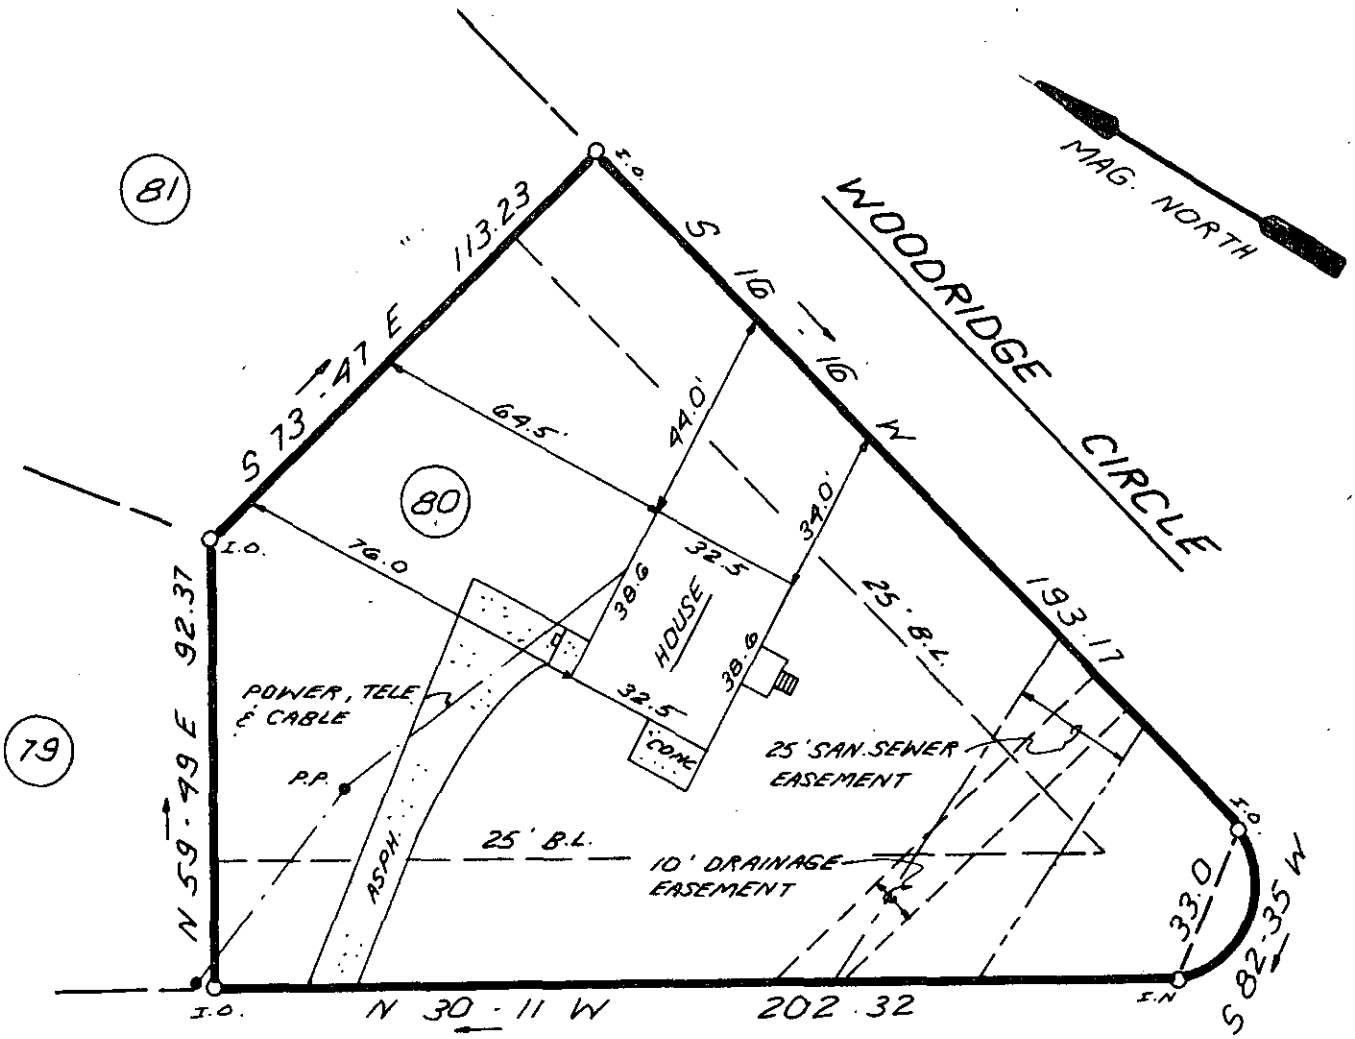

FILED
GREENVILLE CO. S. C.
JAN 24 2 03 PM '84
DONNIE S. TANKERSLEY
R.M.C.

22962

10-H-4

40 0 40 80
SCALE: 1" = 40' FEET

THIS IS TO CERTIFY THAT THE PROPERTY SHOWN ON THIS PLAT WAS SURVEYED UNDER MY DIRECT SUPERVISION. PROPERTY LINES AND IMPROVEMENTS SHOWN ARE LOCATED CORRECTLY AND THAT NO VISIBLE ENCROACHMENTS EXIST UNLESS OTHERWISE SHOWN. THIS PROPERTY IS NOT LOCATED IN A DESIGNATED FLOOD HAZARD AREA.

SOUTH CAROLINA REGISTERED LAND SURVEYOR 8809 W. B. HUNTLEY III

RLS: W. B. HUNTLEY III
NO: 8809

STATE OF SOUTH CAROLINA
GREENVILLE COUNTY

WINDSOR PARK
LOT 80
PROPERTY OF

KENNETH T. SEWELL

SCTO -----3 JA24 84 085

FREELAND & ASSOCIATES
Engineers • Land Surveyors
318 WEST STONE AVENUE.
GREENVILLE, S.C.
(803) 271-4924

PLAT BOOK	RR-25
DEED BOOK	1090-160
TAX MAP	M 9-2-1-87
PARTY CHIEF	D.G.
DRAWN	K. E. G.
DATE	1-20-84
DWG. NO.	10336 00CD

THE PRINT MACHINE, INC. N3 70