MICROFILM

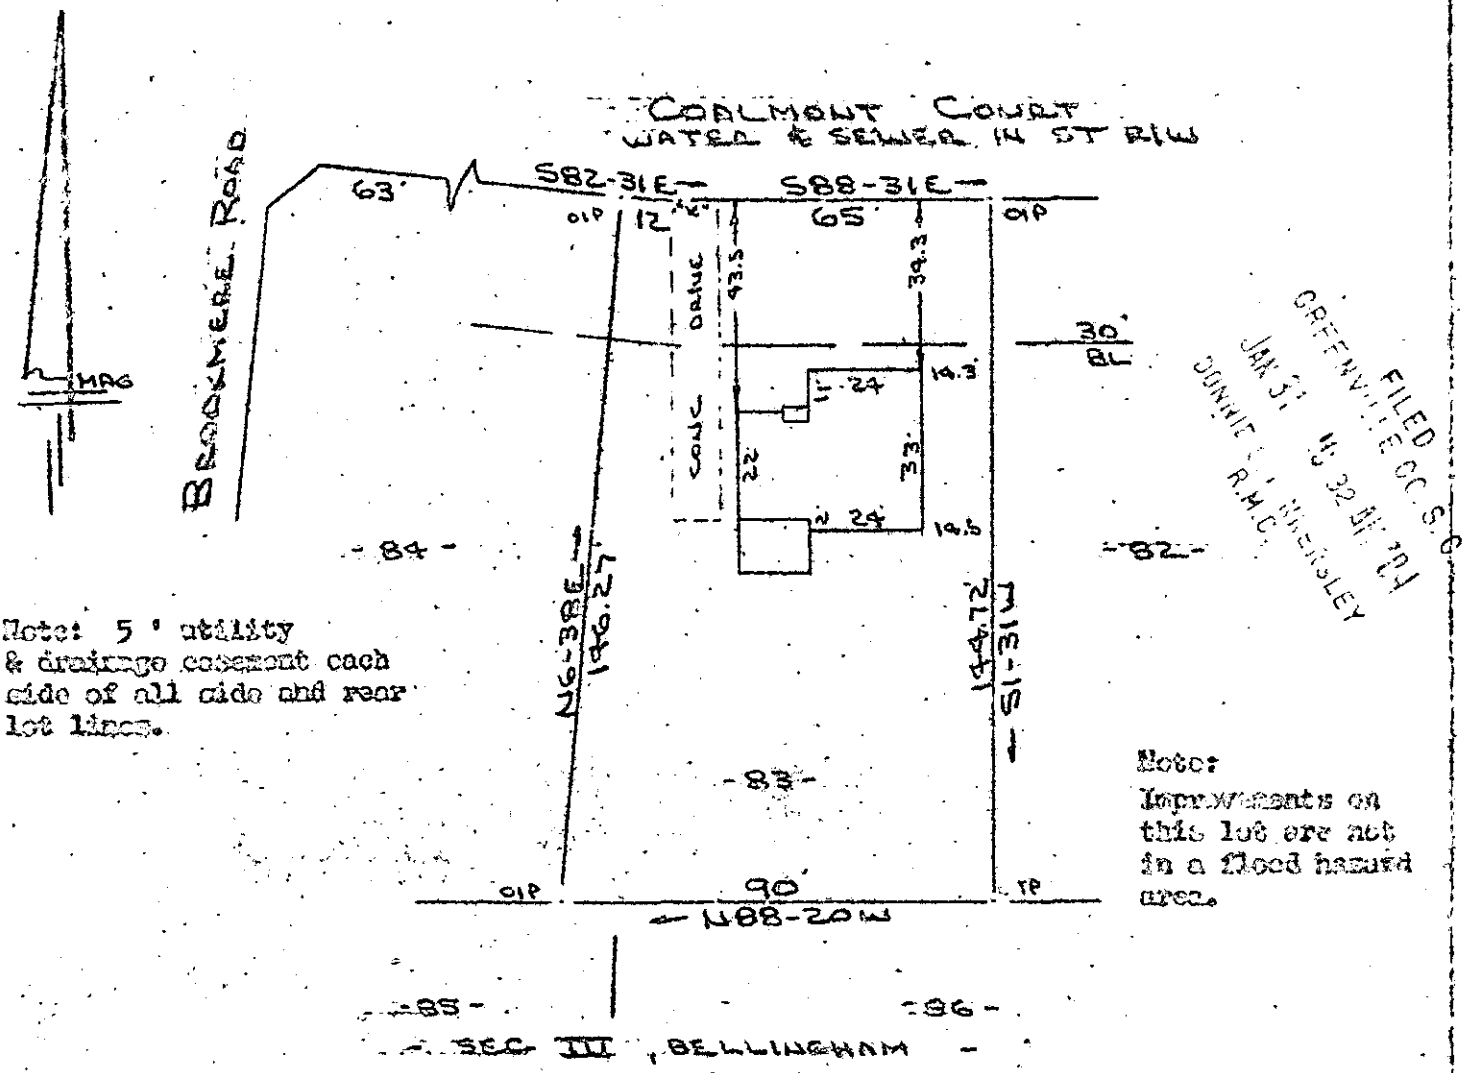

Note: 5' utility & drainage easement each side of all side and rear lot lines.

Note: Improvements on this lot are not in a flood hazard area.

PROPERTY OF
JOHN THOMAS CAMPBELL, JR. & SHERRI CATE CAMPBELL
SIMPSONVILLE, S.C.
27 JAN 1984

40 20 0 40

This is to certify that on the 27th day of January, 1984, I surveyed the property shown on this plat, being known as Lot 83 on plat of SEARCH NO. EV [illegible] and recorded in the RMC Office Greenville County, S. C., in Plat Book "[illegible]" at Page [illegible]; and that the property lines, walls and buildings are as shown hereon, and that the walls and buildings located on said lot do not encroach or project on adjacent street or property, and that no adjacent walls or buildings encroach or project on said premises, and no power lines cross this property except as shown hereon.

10-H-18 23615

Recordable Plat

JAN 31 1984

CAROLINA SURVEYING CO.
112 [illegible] S. C.

R. B. Bruce

261/52