


FILED
GREENVILLE CO. S. C.
FEB 3 3 02 PM '84
JUNNIE S. TANKERSLEY
R.M.C.



FEB 3 1984

10-H-36
24094 ✓

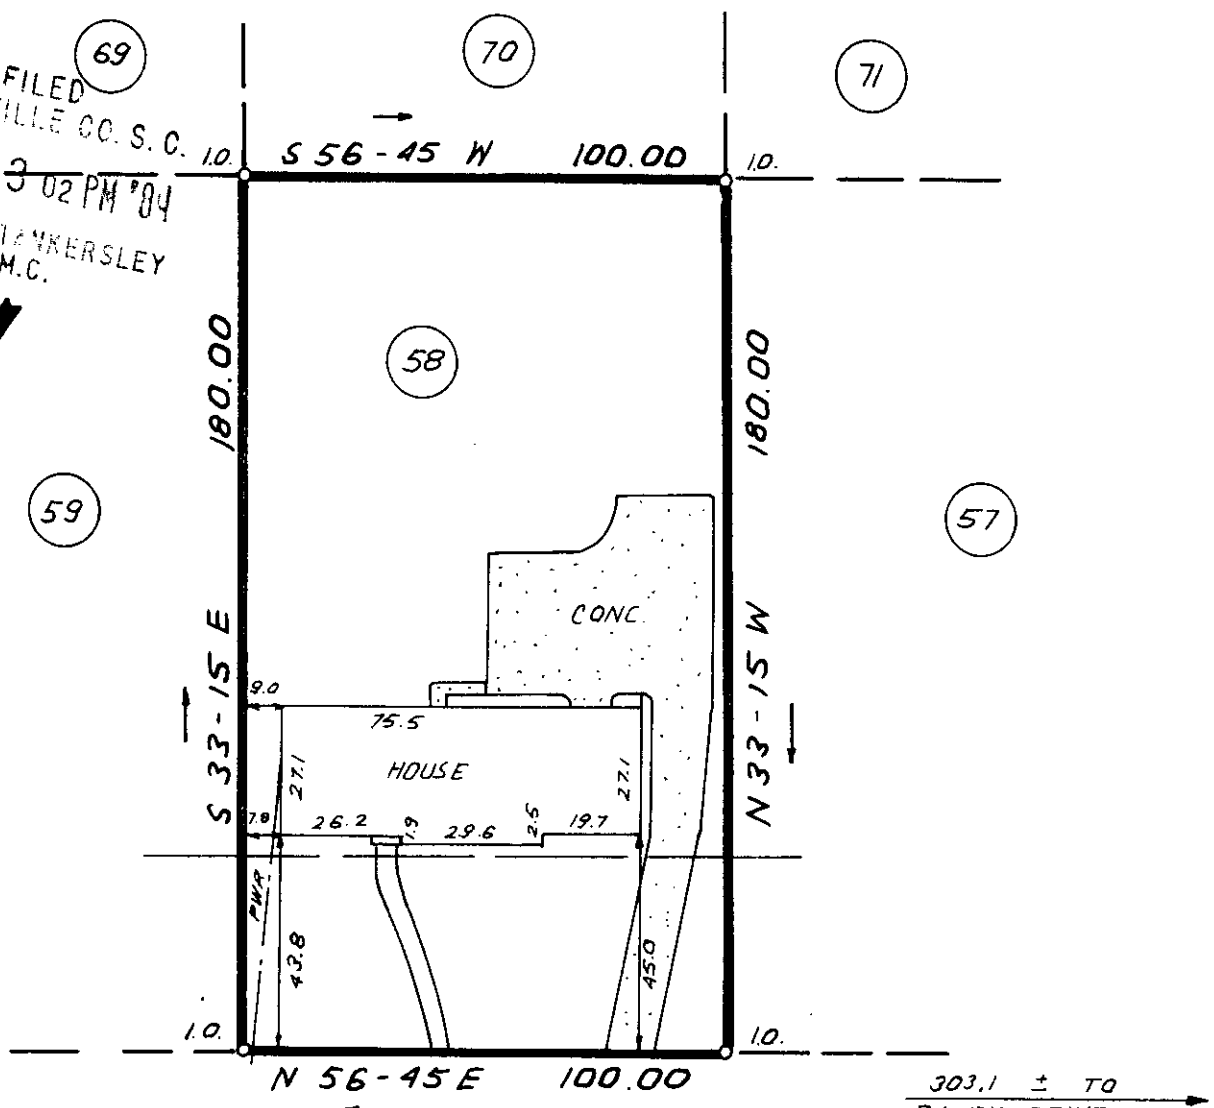

THIS IS TO CERTIFY THAT THE PROPERTY SHOWN ON THIS PLAT WAS SURVEYED UNDER MY DIRECT SUPERVISION. PROPERTY LINES AND IMPROVEMENTS SHOWN ARE LOCATED CORRECTLY AND THAT NO VISIBLE ENCROACHMENTS EXIST UNLESS OTHERWISE SHOWN THIS PROPERTY IS NOT LOCATED IN A DESIGNATED FLOOD HAZARD AREA.

**STATE OF SOUTH CAROLINA
GREENVILLE COUNTY**

FREELAND & ASSOCIATES
Engineers • Land Surveyors
318 WEST STONE AVENUE.
GREENVILLE, S.C.
(803) 271-4924

EDWARDS FOREST
LOT 58-SEC. 2
PROPERTY OF
THOMAS W. GUINNEE &
LAREE H. GUINNEE

PLAT BOOK	RR - 20
DEED BOOK	
TAX MAP	T 29.2 - 1 - 60
PARTY CHIEF	J. C.
DRAWN	B. R.
DATE	1 - 27 - 84
DWG. NO.	10,430

**SOUTH CAROLINA
REGISTERED LAND SURVEYOR**
4781
JAMES B. FREELAND
SLS: JAMES R. FREELAND
NO: 4781

SC10 --- 1 FEB 03 84 756