MICROFILMED

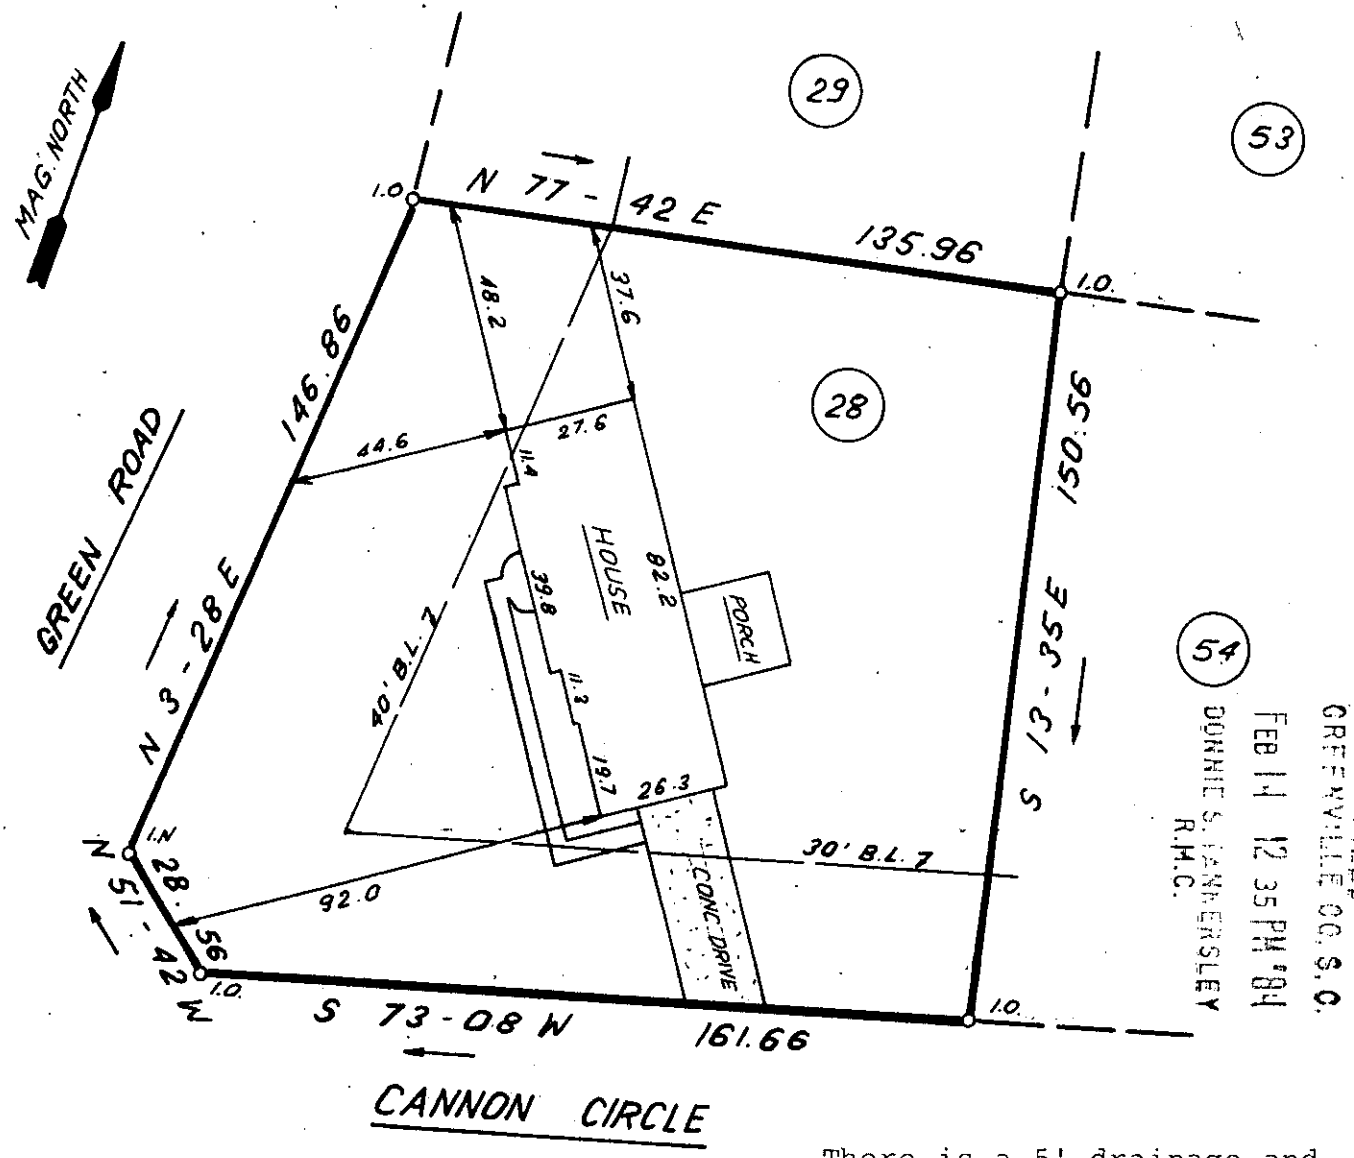


FILED
GREENVILLE CO. S.C.
FEB 14 12 35 PM '84
DONNIE S. TANKERSLEY
R.M.C.

There is a 5' drainage and utilities easement along each side and rear lot lines.

25024

FEB 14 1984

10-H-57

40 0 40 80

SCALE: 1" = 40' FEET

THIS IS TO CERTIFY THAT THE PROPERTY SHOWN ON THIS PLAT WAS SURVEYED UNDER MY DIRECT SUPERVISION. PROPERTY LINES AND IMPROVEMENTS SHOWN ARE LOCATED CORRECTLY AND THAT NO VISIBLE ENCROACHMENTS EXIST UNLESS OTHERWISE SHOWN. THIS PROPERTY IS NOT LOCATED IN A DESIGNATED FLOOD HAZARD AREA.

SOUTH CAROLINA REGISTERED LAND SURVEYOR 4781

RLS: JAMES R. FREELAND
NO: 4781

**STATE OF SOUTH CAROLINA**
**GREENVILLE COUNTY**

PINEBROOK FOREST
LOT 28 SEC. 2
PROPERTY OF
RICHARD C. SMITH
ANN A. SMITH

GCTO - FEB 14 84 027

**FREELAND & ASSOCIATES**
*Engineers • Land Surveyors*
318 WEST STONE AVENUE.
GREENVILLE, S.C.
(803) 271-4924

| | |
|---|---|
| PLAT BOOK | 4X 48-49 |
| DEED BOOK | |
| TAX MAP | 574.11 - 1 - 28 |
| PARTY CHIEF | M.L.C |
| DRAWN | B.R |
| DATE | 2 - 9 - 84 |
| DWG. NO. | 10493 3.00CD |

THE PRINT MACHINE, INC. N37703