MICROFILMED

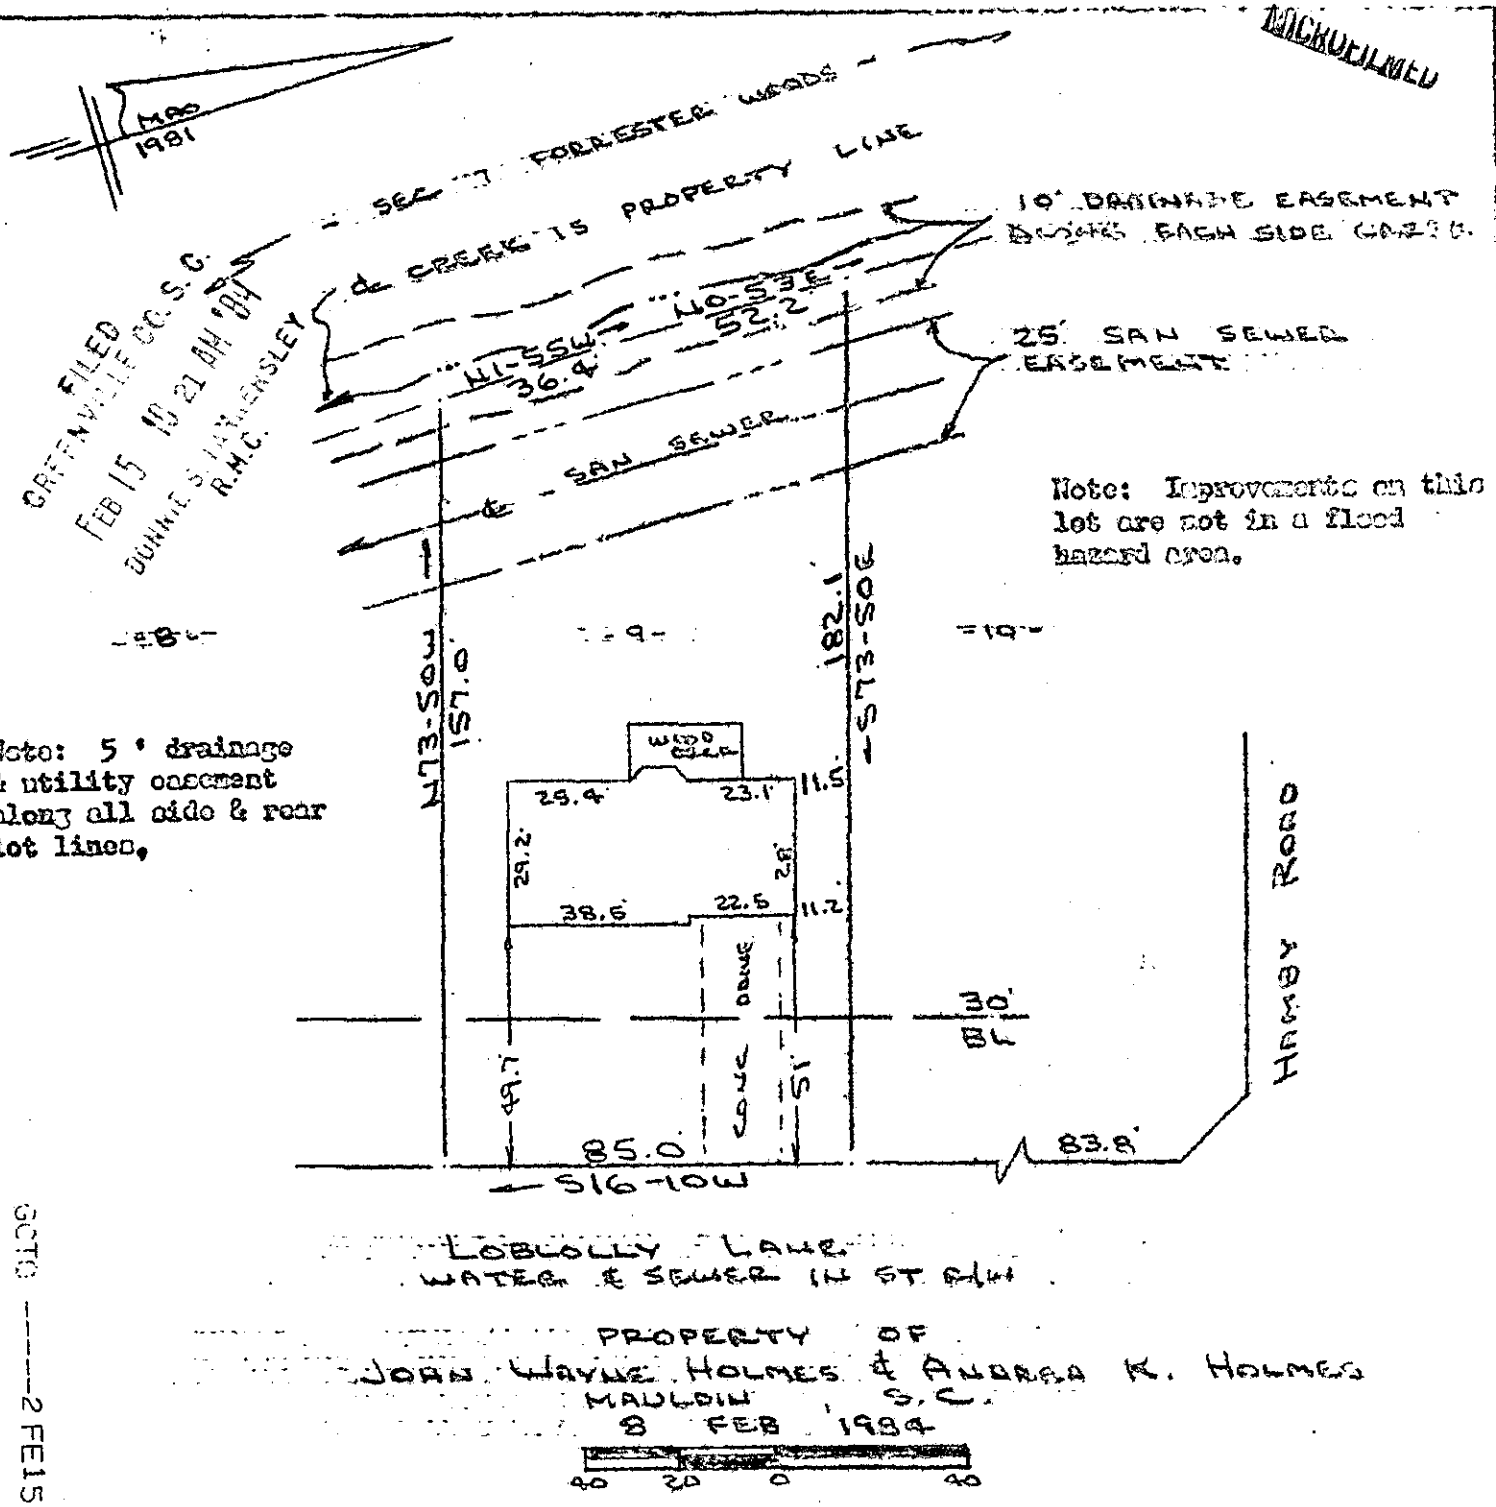

PROPERTY OF
JOHN WAYNE HOLMES & ANDREA K. HOLMES
MAULDIN S.C.
8 FEB 1984

40 20 0 40

This is to certify that on the 8th day of February, 1984, I surveyed the property shown on this plat, being known as lot 9 on plat of SECTION NO. 5 FORESTER WOODS and recorded in the RMC Office Greenville County, S. C., in Plat Book " 8 - P " at Page 100; and that the property lines, walls and buildings are as shown hereon, and that the walls and buildings located on said lot do not encroach or project on adjacent street or property, and that no adjacent walls or buildings encroach or project on said premises, and no power lines cross this property except as shown hereon.

25159

Recordable Plat

10H-59

FEB 15 1984

CAROLINA SURVEYING CO.
112 Lowndes St.
Greenville, S. C.

R. B. Bruce, RLS (#5021)

3.00CI

BOOK 1407 PAGE 84 FEB 2 ----

M9.3-