


FILED
GREENVILLE, CO. S. C.
FEB 20 1 00 PM '84
DONNIE S. TANKERSLEY
R.M.C.

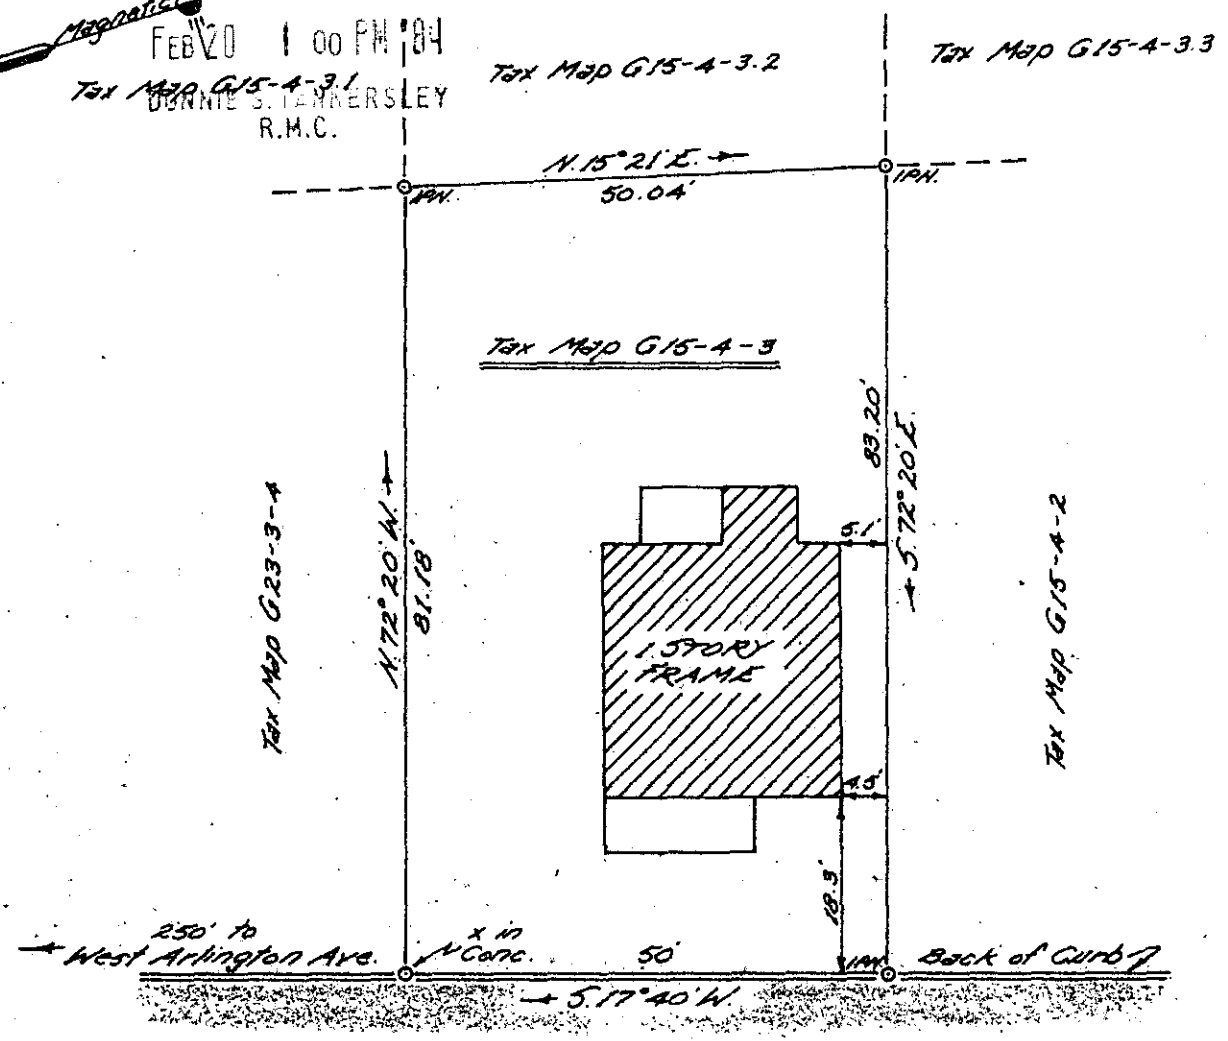

LANFORD STREET

PROPERTY OF
D. ALLEN WEST

Located in Greer

GREENVILLE COUNTY, SOUTH CAROLINA

SCALE: 1" = 20 FEET JAN. 20, 1984




This is to certify that on January 19, 1984, I surveyed the property shown on this plat, and the same is correct, being shown as the Eastern part of Lot No.21, on plat of Westmorland Circle, and that the property lines, walls and building shown thereon on said lot do not encroach or project on adjacent streets or property, and that no adjacent buildings or walls encroach or project on said premises. This property is not located in a Flood Plane.

25559

John A. Simmons

Registered Surveyor in S.C. #2212

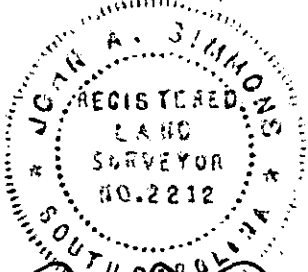

FEB 20 1984

John A. Simmons

10-H-78

Tri-State Surveyors
109 Few Street
Greer, S. C. 29651