


MICROFILMED

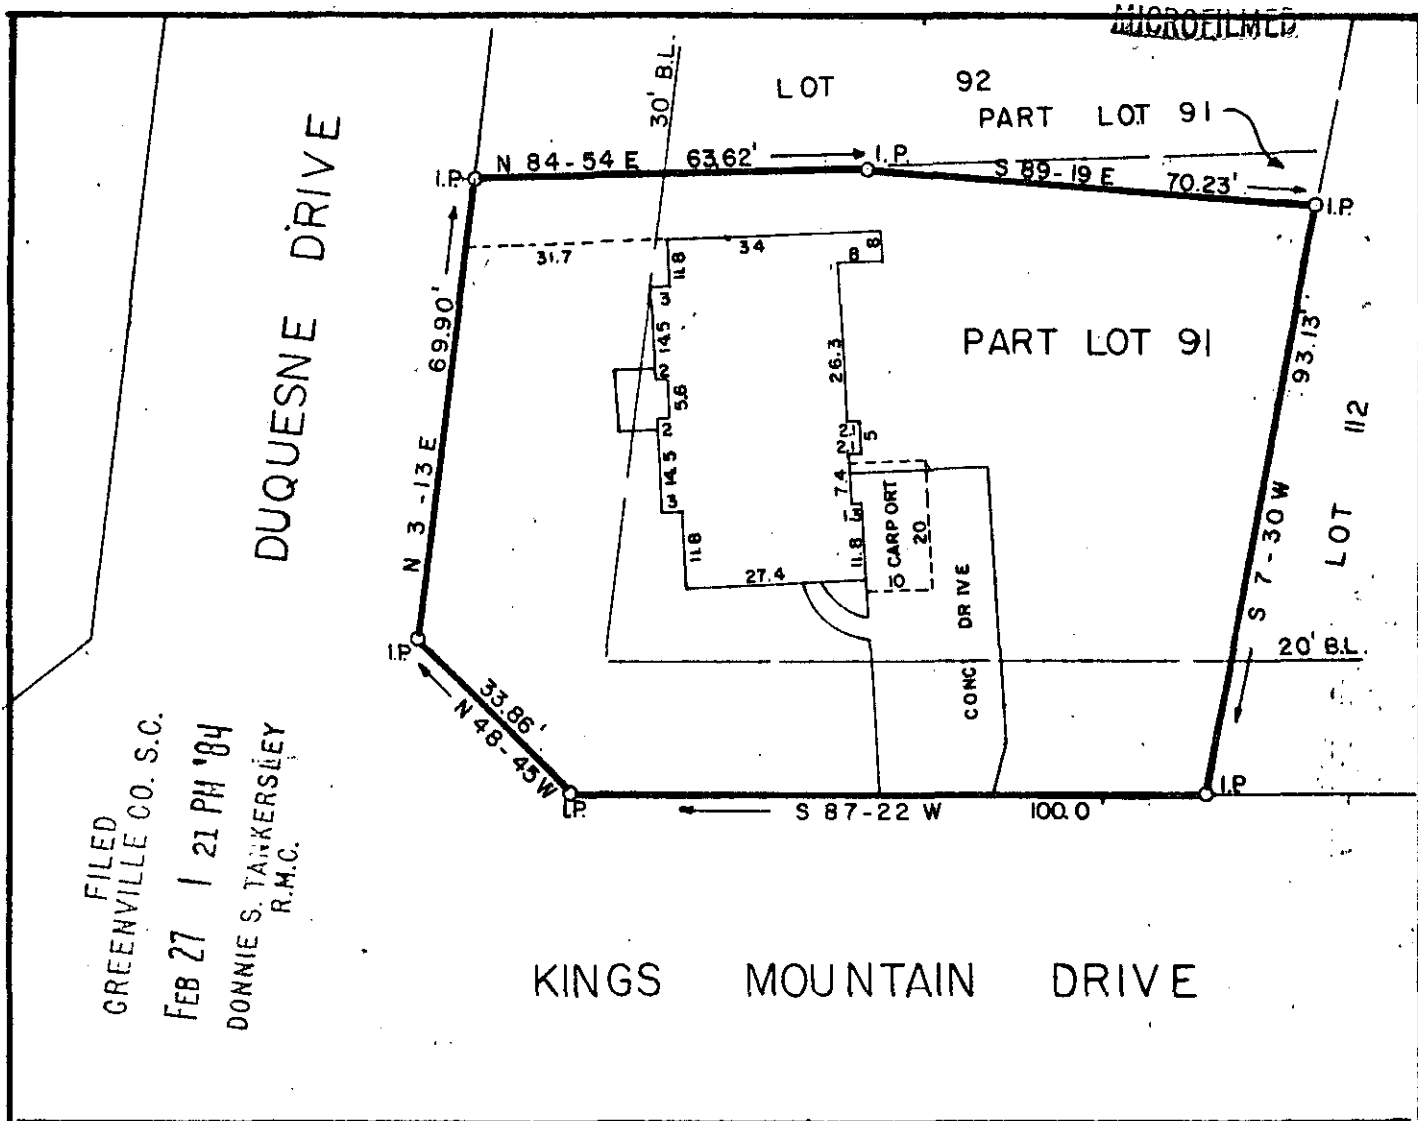

FILED  
 GREENVILLE CO. S.C.  
 FEB 27 1 21 PM '84  
 DONNIE S. TANKERSLEY  
 R.M.C.



FEB 27 1984

10J-2

PROPERTY OF 26307 ✓

JAMES KEITH STONE

GREENVILLE CO., - S.C.

Scale 1" = 30' February, 1984

This is to certify that on the 22nd day of February, 1984, we surveyed the property shown on this plat being known as Part Lot 91 on plat of Canebrake I, recorded in plat book 5-P, page 28, Office of R.M.C., Greenville County, S.C.; and that the property lines, walls and buildings are as shown hereon; that the buildings located on said lot do not encroach or project on adjacent streets or property; and that no adjacent buildings or walls encroach or project on said premises; and from information from Greenville County, this structure is not in a designated flood area.

