MICROFILMED

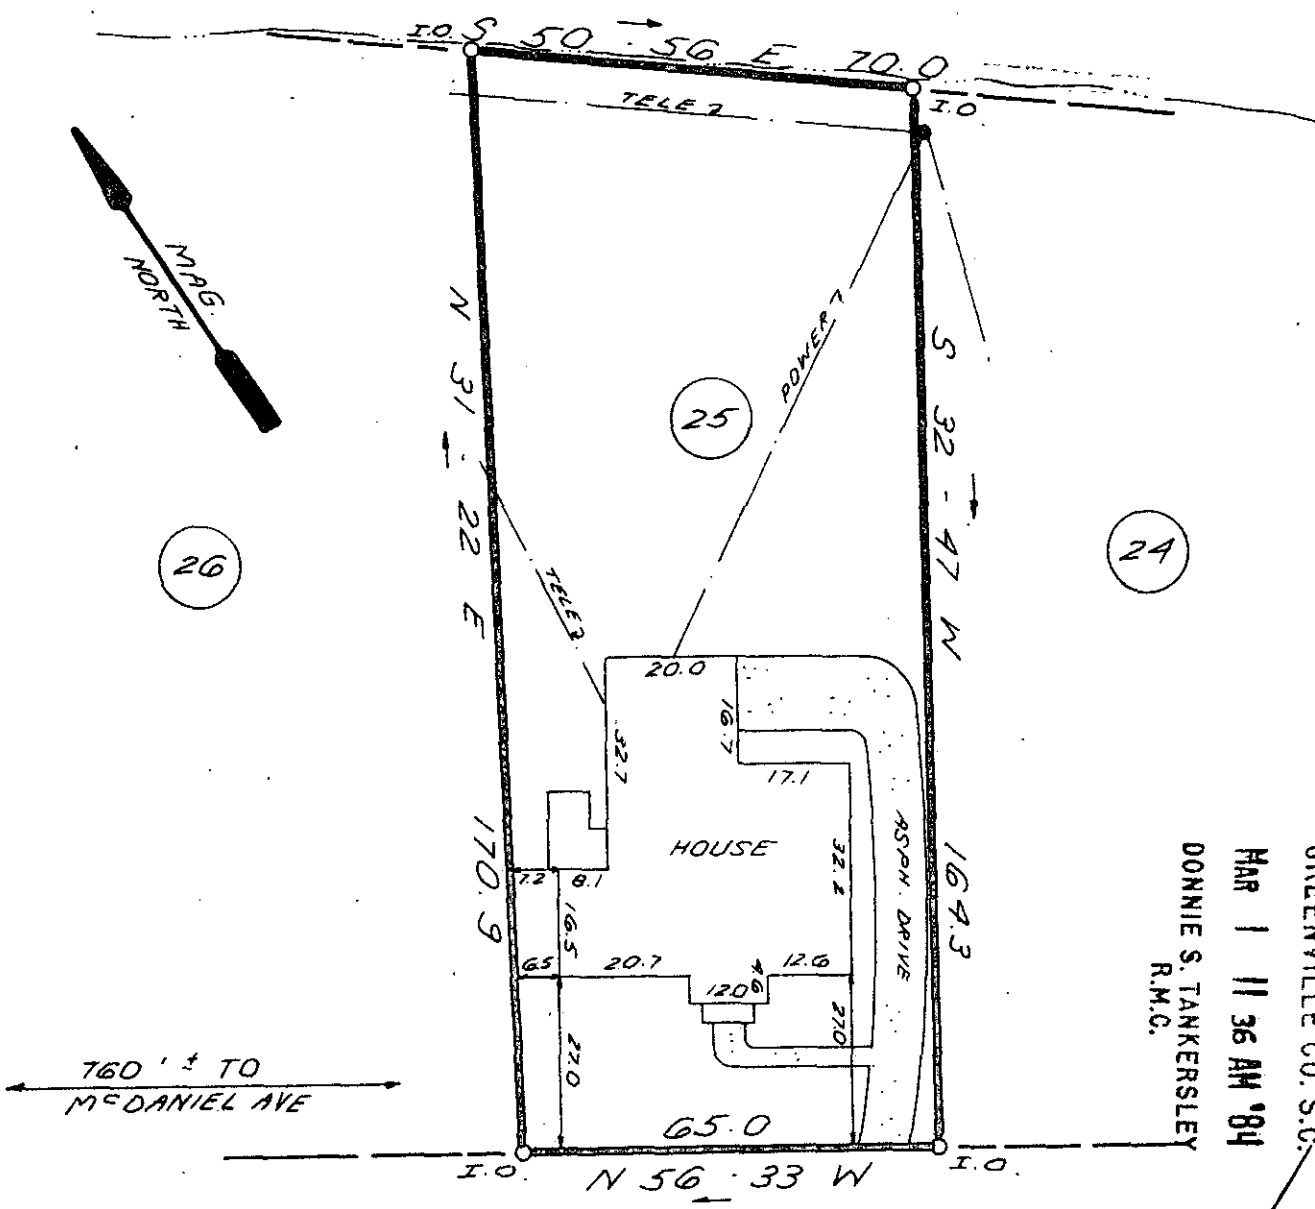

FILED
GREENVILLE CO. S.C.
MAR 1 11 36 AM '84
DONNIE S. TANKERSLEY
R.M.C.

26783

MAR 1 1984

30 0 30 60
SCALE: 1" = 30' FEET

10-J-22

THIS IS TO CERTIFY THAT THE PROPERTY SHOWN ON THIS PLAT WAS SURVEYED UNDER MY DIRECT SUPERVISION. PROPERTY LINES AND IMPROVEMENTS SHOWN ARE LOCATED CORRECTLY AND THAT NO VISIBLE ENCROACHMENTS EXIST UNLESS OTHERWISE SHOWN. THIS PROPERTY IS NOT LOCATED IN A DESIGNATED FLOOD HAZARD AREA.

SOUTH CAROLINA REGISTERED LAND SURVEYOR 4781 JAMES R. FREELAND

RLS: JAMES R. FREELAND
NO: 4781

STATE OF SOUTH CAROLINA
GREENVILLE COUNTY

JOHN T. JENKINSON ESTATE
LOT 25
PROPERTY OF
VIRGINIA MILLER RODGERS

FREELAND & ASSOCIATES
Engineers • Land Surveyors
318 WEST STONE AVENUE.
GREENVILLE, S.C.
(803) 271-4924

PLAT BOOK	H - 208
DEED BOOK	1114 - 943
TAX MAP	203 - 03 - 38
PARTY CHIEF	J. C.
DRAWN	K.E.G.
DATE	FEB. 28, 1984
DWG. NO.	10,607

THE PRINT MACHINE, INC. N37103