


FILED
GREENVILLE CO. S.C.
MAR 1 4 02 PM '84
DONNIE S. TANKERSLEY
R.M.C.

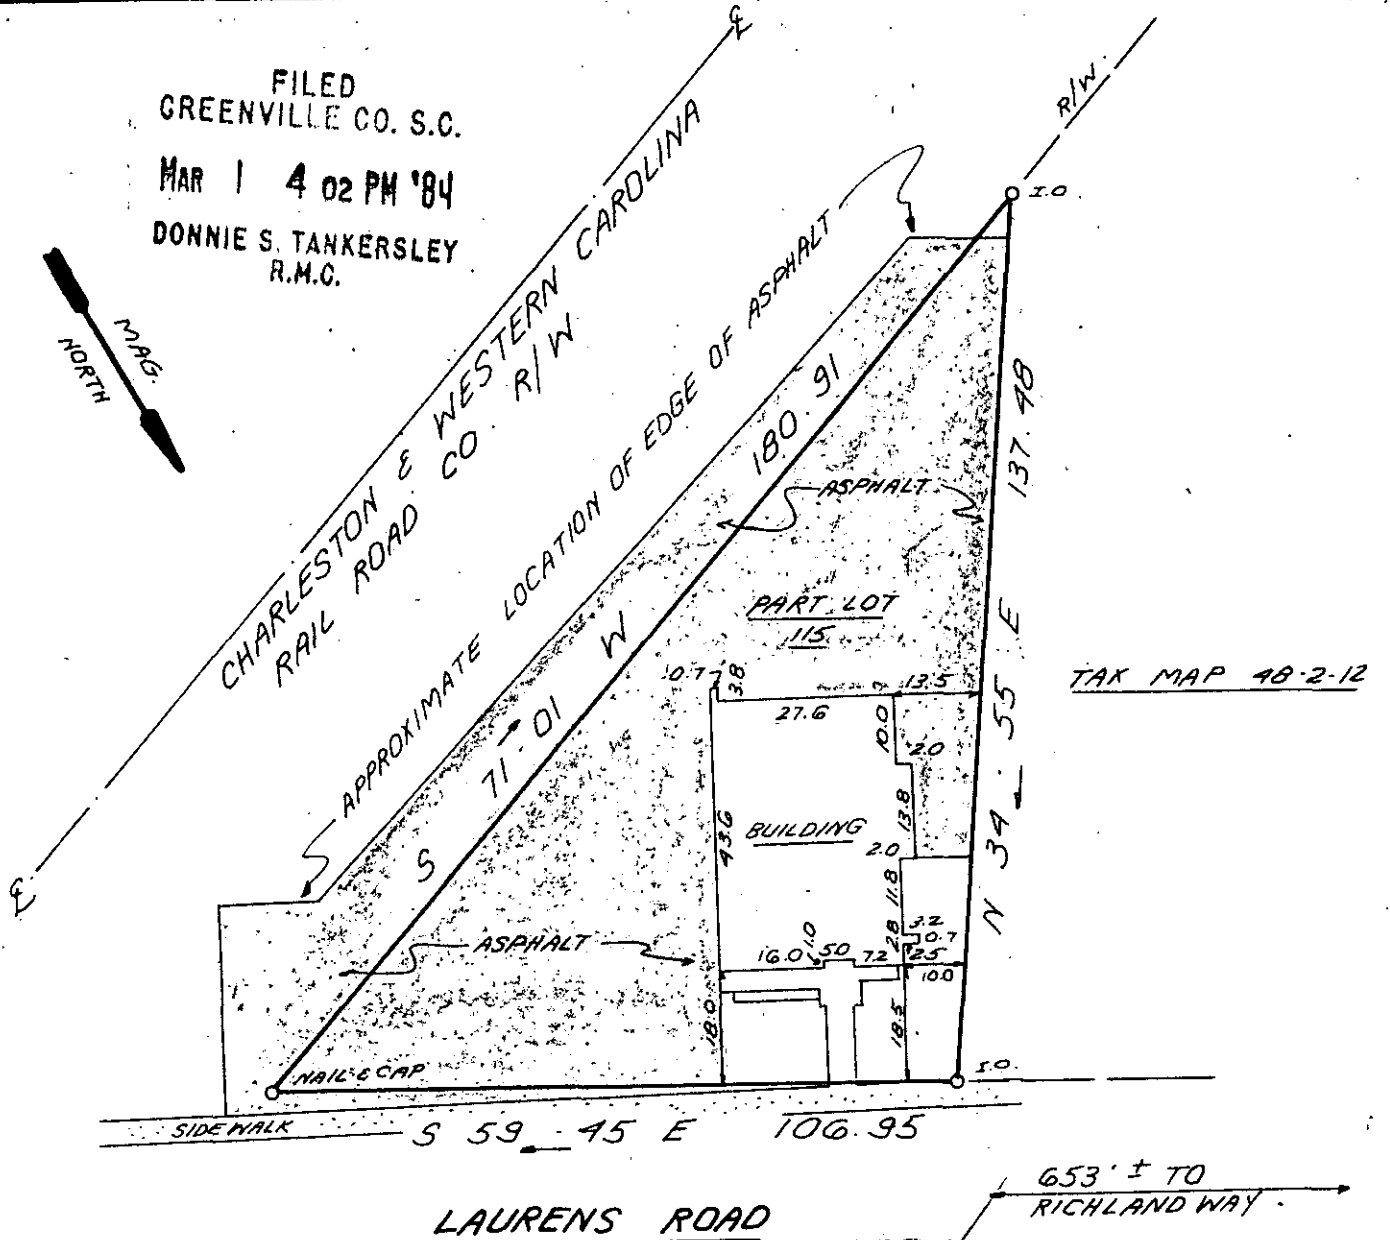

LAURENS ROAD

26832

MAR 1 1984

10J-29



THIS IS TO CERTIFY THAT THE PROPERTY SHOWN ON THIS PLAT WAS SURVEYED UNDER MY DIRECT SUPERVISION. PROPERTY LINES AND IMPROVEMENTS SHOWN ARE LOCATED CORRECTLY AND THAT NO VISIBLE ENCROACHMENTS EXIST UNLESS OTHERWISE SHOWN. THIS PROPERTY IS NOT LOCATED IN A DESIGNATED FLOOD HAZARD AREA.

**STATE OF SOUTH CAROLINA
GREENVILLE COUNTY**

FREELAND & ASSOCIATES
Engineers • Land Surveyors
318 WEST STONE AVENUE.
GREENVILLE, S.C.
(803) 271-4924

EAST PARK
BLOCK J; PART LOT 115
PROPERTY OF
ROBERT J. WILSON, III

| | |
|-------------|---------------|
| PLAT BOOK | 7U-96 |
| DEED BOOK | 1125-868 |
| TAX MAP | 48-2-11 |
| PARTY CHIEF | L.T. |
| DRAWN | K.E.G. |
| DATE | FEB. 29, 1984 |
| DWG. NO. | 10,632.00CD |

GCTO -----3 MR 1 84 098



James R. Freeland
JAMES R. FREELAND
RLS: JAMES R. FREELAND
NO: 4781