MICROFILMED

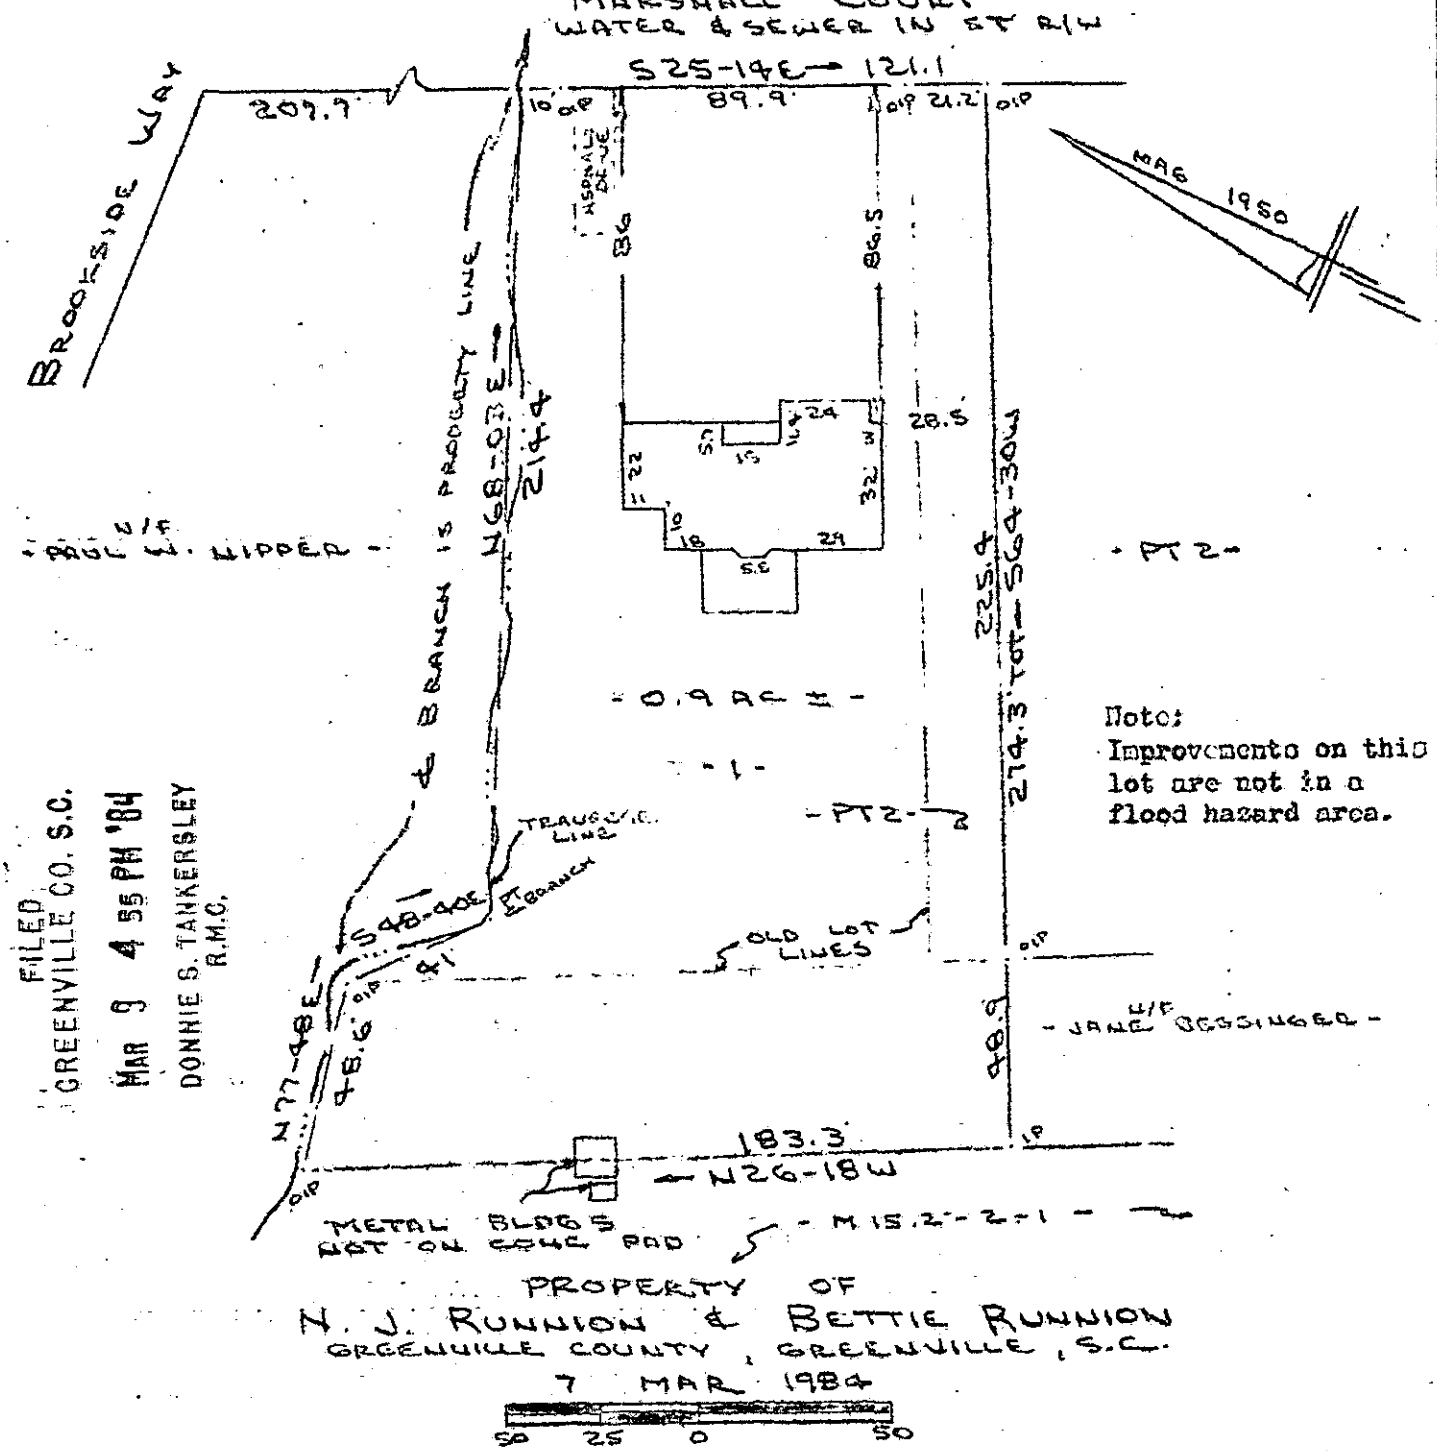

Note:
Improvements on this lot are not in a flood hazard area.

FILED
GREENVILLE CO. S.C.
MAR 9 4 55 PM '84
DONNIE S. TANKERSLEY
R.M.C.

This is to certify that on the 7th day of March, 1984, I surveyed the property shown on this plat, being known as lot 1 and part of lot 2 (0.9 acre) on plat of MARSHALL COURT and recorded in the RMC Office Greenville County, S. C., in Plat Book " T " at Page 261 and also known as PROPERTY OF N. J. RUNNION & BETTIE RUNNION and recorded in Plat Book at Page ; and that the property lines, walls and buildings are as shown hereon, and that the walls and buildings located on said lot do not encroach or project on adjacent street or property, and that no adjacent walls or buildings encroach or project on said premises, and no power lines cross this property except as shown hereon.

10-J-58 27778 V R. B. Bruce

CAROLINA SURVEYING CO.
112 Manly St.
Greenville, S. C.

R. B. Bruce, RLS #1952

Recordable Plat

RECD ----2 MR 9 84 037
3.00CI