

MICROFILMED

FILED 10. S 26 - 35 E 90.0
GREENVILLE CO. S.C.

MAR 13 4 09 PM '84

DONNIE S. TANKERSLEY
R.M.C.



PT LOT 89

PT LOT 89

LOT 88

LOT 87

171.35

173.2

N 64 - 35 E

S 64 - 35 N

1.0

1.0

90' TO WILDERNESS LANE

N 25 - 25 N 90.0

OLD PROPERTY LINE


CONC. CAR PORT

WOOD DECK

HOUSE

ASPHALT DRIVE

BRICK WALK

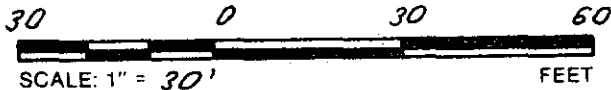

TRAILS END

MAR 13 1984

28115
10J-64

THIS IS TO CERTIFY THAT THE PROPERTY SHOWN ON THIS PLAT WAS SURVEYED UNDER MY DIRECT SUPERVISION. PROPERTY LINES AND IMPROVEMENTS SHOWN ARE LOCATED CORRECTLY AND THAT NO VISIBLE ENCROACHMENTS EXIST UNLESS OTHERWISE SHOWN. THIS PROPERTY IS NOT LOCATED IN A DESIGNATED FLOOD HAZARD AREA.

SOUTH CAROLINA REGISTERED LAND SURVEYOR 4781
 JAMES R. FREELAND
 RLS: JAMES R. FREELAND
 NO: 4781

STATE OF SOUTH CAROLINA
GREENVILLE COUNTY

CLEVELAND FOREST
LOT 88 & PT 89
PROPERTY OF
DOROTHY A. TUCKER

FREELAND & ASSOCIATES
Engineers • Land Surveyors
318 WEST STONE AVENUE.
GREENVILLE, S.C.
(803) 271-4924

PLAT BOOK	M - 137
DEED BOOK	1127 - 213
TAX MAP	671 - 1 - 21
PARTY CHIEF	J.E.C.
DRAWN	B.R.
DATE	3 - 9 - 84
DWG. NO.	10, 676