


MICROFILMED

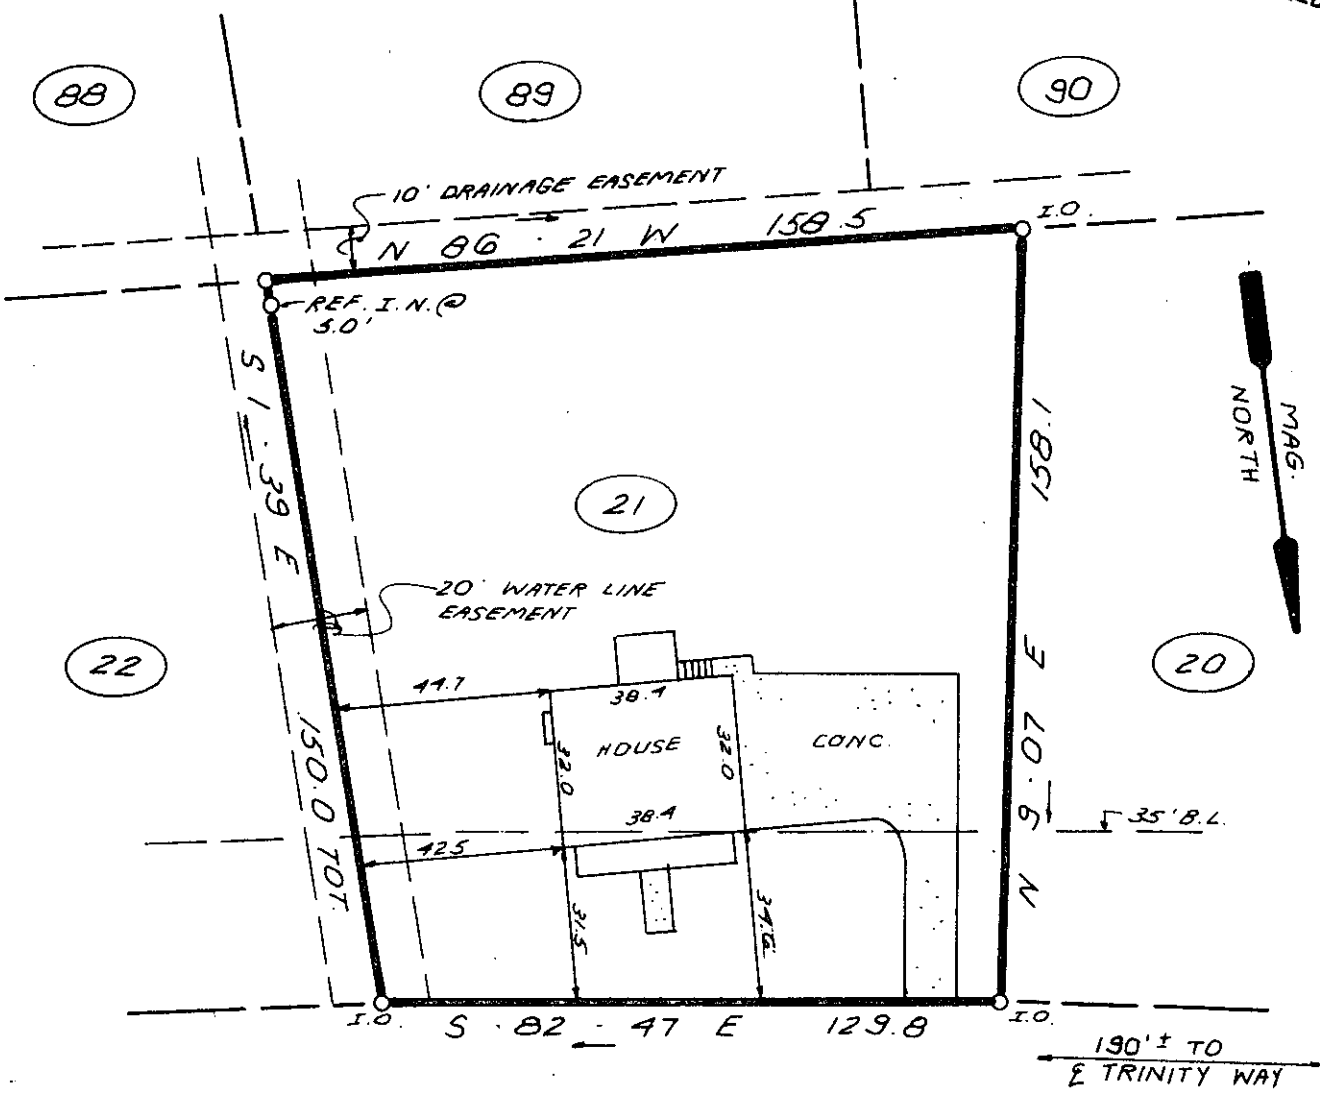

DEVONSHIRE LANE


28765



10-J-83

FILED
 GREENVILLE CO. S.C.
 MAR 19 11 38 AM '84
 DONNIE S. TANKERSLEY
 R.M.C.

THIS IS TO CERTIFY THAT THE PROPERTY SHOWN ON THIS PLAT WAS SURVEYED UNDER MY DIRECT SUPERVISION. PROPERTY LINES AND IMPROVEMENTS SHOWN ARE LOCATED CORRECTLY AND THAT NO VISIBLE ENCROACHMENTS EXIST UNLESS OTHERWISE SHOWN. THIS PROPERTY IS NOT LOCATED IN A DESIGNATED FLOOD HAZARD AREA.

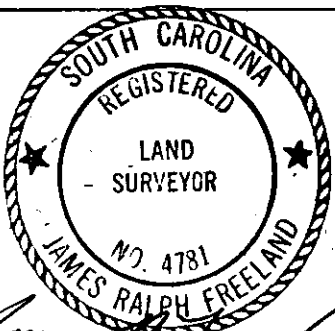

STATE OF SOUTH CAROLINA
 GREENVILLE COUNTY

FREELAND & ASSOCIATES
 Engineers • Land Surveyors
 318 WEST STONE AVENUE,
 GREENVILLE, S.C.
 (803) 271-4924

NORTHWOOD HILLS
 SEC. 1A - LOT 21
 PROPERTY OF
 JERRY R. ALEXANDER
 DIANNE S. ALEXANDER

PLAT BOOK	4X-98 & 99
DEED BOOK	1186-441
TAX MAP	428-1-92
PARTY CHIEF	F.V.C.
DRAWN	K.E.G.
DATE	3-12-1984
DWG. NO.	10685

RLS: JAMES R. FREELAND
 NO: 4781

2 MR19 34 856 3.00CT