

MICROFILMED

FILED  
GREENVILLE CO. S.C.  
MAR 22 11 47 AM '84  
DONNIE S. TANKERSLEY  
R.M.C.


75

88

89

74

73

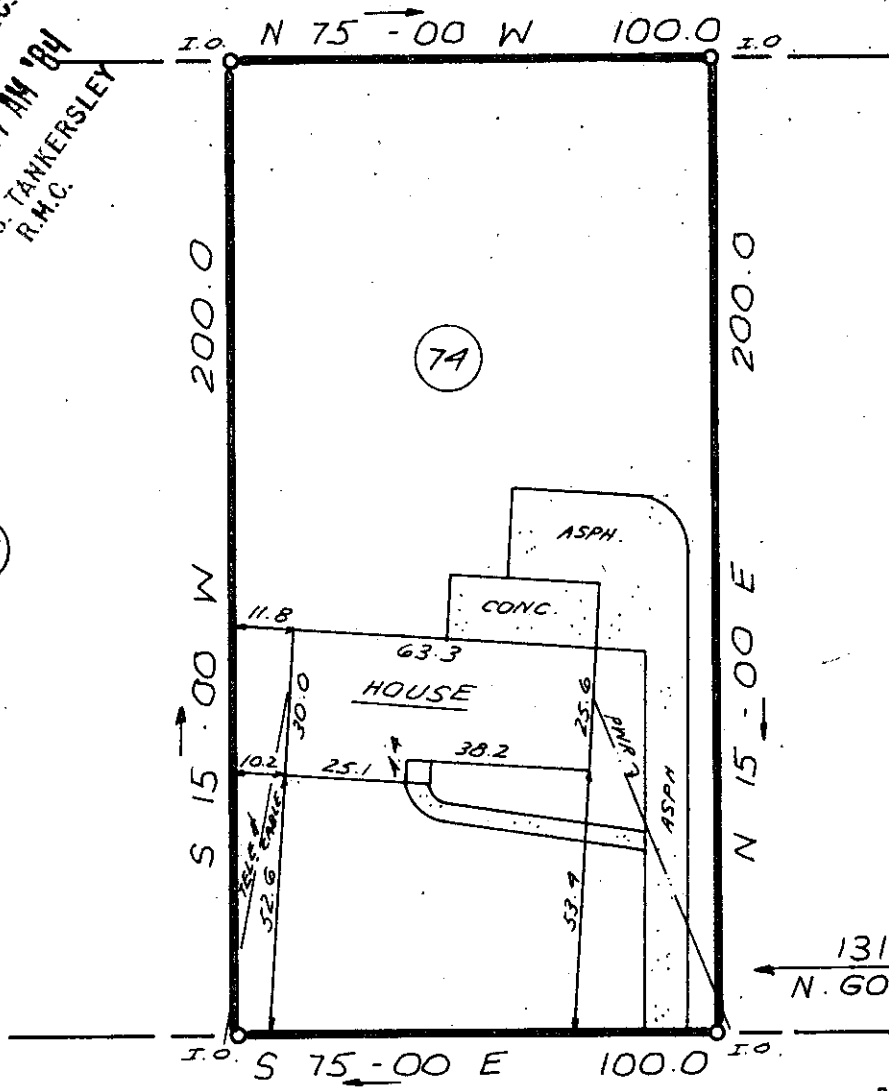

MAR 22 1984

SYCAMORE DRIVE

10-J-99 ✓  
29221



THIS IS TO CERTIFY THAT THE PROPERTY SHOWN ON THIS PLAT WAS SURVEYED UNDER MY DIRECT SUPERVISION. PROPERTY LINES AND IMPROVEMENTS SHOWN ARE LOCATED CORRECTLY AND THAT NO VISIBLE ENCROACHMENTS EXIST UNLESS OTHERWISE SHOWN. THIS PROPERTY IS NOT LOCATED IN A DESIGNATED FLOOD HAZARD AREA.

**SOUTH CAROLINA REGISTERED LAND SURVEYOR**  
8809  
*W. B. HUNTLEY III*  
RLS: W. B. HUNTLEY III  
NO: 8809

**STATE OF SOUTH CAROLINA  
GREENVILLE COUNTY**

EASTDALE DEVELOPMENT  
LOT 74  
PROPERTY OF  
FRED J. BURNS

**FREELAND & ASSOCIATES**  
Engineers • Land Surveyors  
318 WEST STONE AVENUE.  
GREENVILLE, S.C.  
(803) 271-4924

PLAT BOOK	YY-11B & 119
DEED BOOK	753-09
TAX MAP	M 4.1 - 1-26
PARTY CHIEF	G.P.
DRAWN	K.E.G.
DATE	3/15/84
DWG. NO.	10707