


FILED  
GREENVILLE CO. S.C.  
MAR 23 4 10 PM '84  
DONNIE S. TANKERSLEY  
R.M.C.


PECAN DRIVE

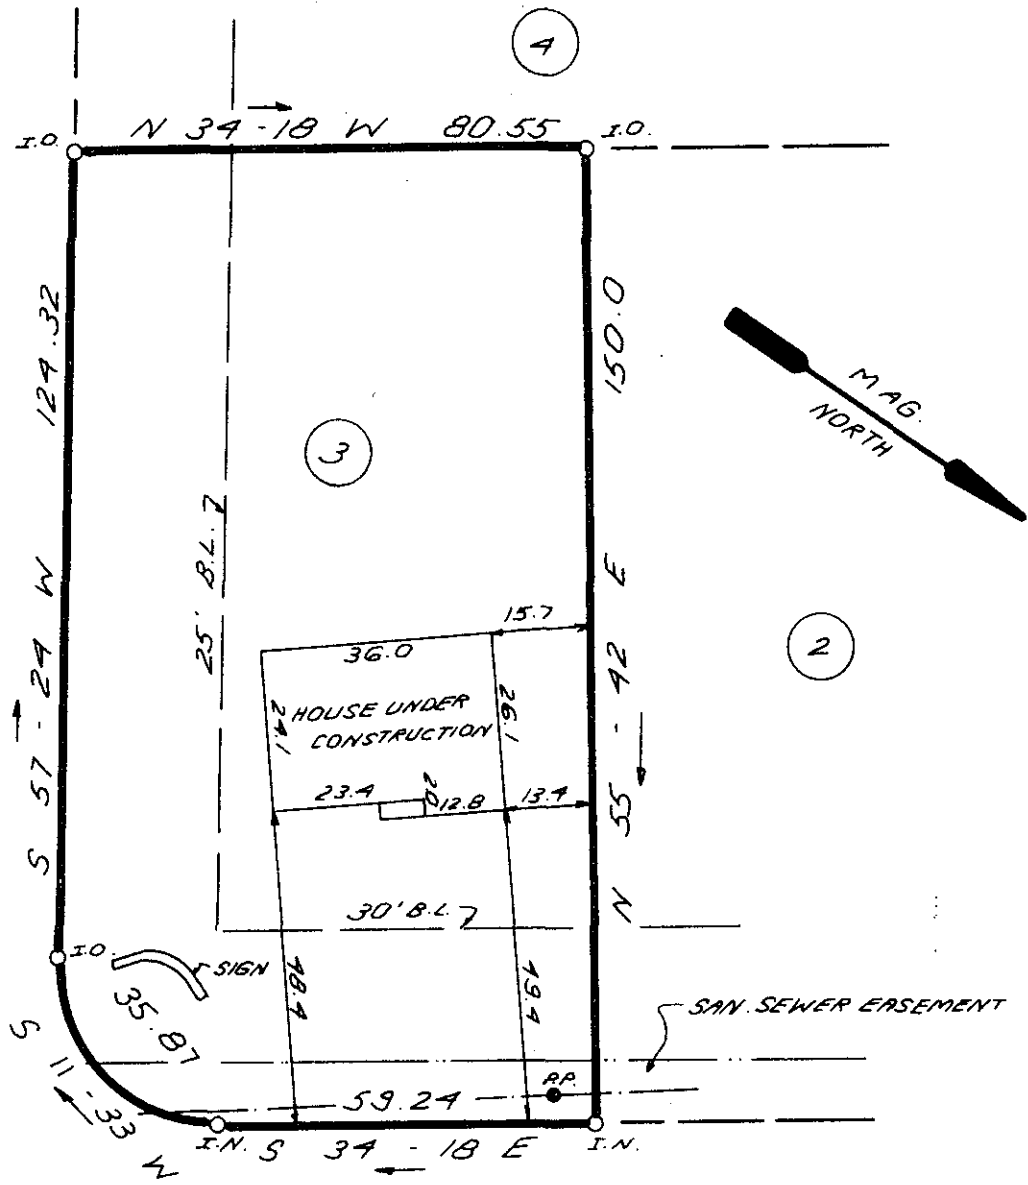

NOTE: 5' DRAINAGE & UTILITY EASEMENT ALONG EACH SIDE OF ALL SIDE & REAR LOT LINES.


HOLLAND ROAD

MAR 23 1984

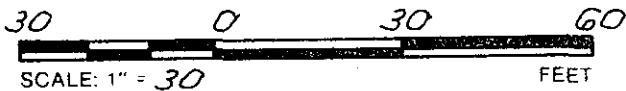

29415 ✓ 10-L-8

THIS IS TO CERTIFY THAT THE PROPERTY SHOWN ON THIS PLAT WAS SURVEYED UNDER MY DIRECT SUPERVISION. PROPERTY LINES AND IMPROVEMENTS SHOWN ARE LOCATED CORRECTLY AND THAT NO VISIBLE ENCROACHMENTS EXIST UNLESS OTHERWISE SHOWN. THIS PROPERTY IS NOT LOCATED IN A DESIGNATED FLOOD HAZARD AREA

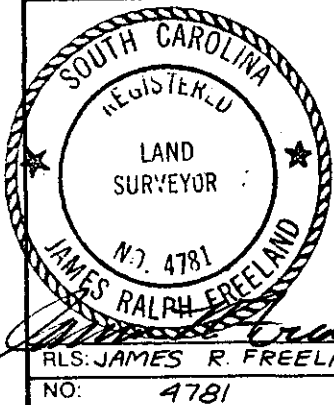

STATE OF SOUTH CAROLINA  
GREENVILLE COUNTY

FREELAND & ASSOCIATES  
Engineers & Land Surveyors  
318 WEST STONE AVENUE.  
GREENVILLE, S.C.  
(803) 271-4924

GILDER CREEK ESTATES  
PHASE 1, LOT 3  
PROPERTY OF

SAN-DELTO BUILDERS

PLAT BOOK	9W-68
DEED BOOK	
TAX MAP	
PARTY CHIEF	J.R.F.
DRAWN	K.E.B.
DATE	3-13-84
DWG. NO.	10,689