


FILED LAURENS ROAD  
GREENVILLE CO. S.C. WATER & SEWER IN RD R/W

MAR 26 2 29 PM '84


DONNIE S. TANKERSLEY  
R.M.C.

M.P.S.  
1977

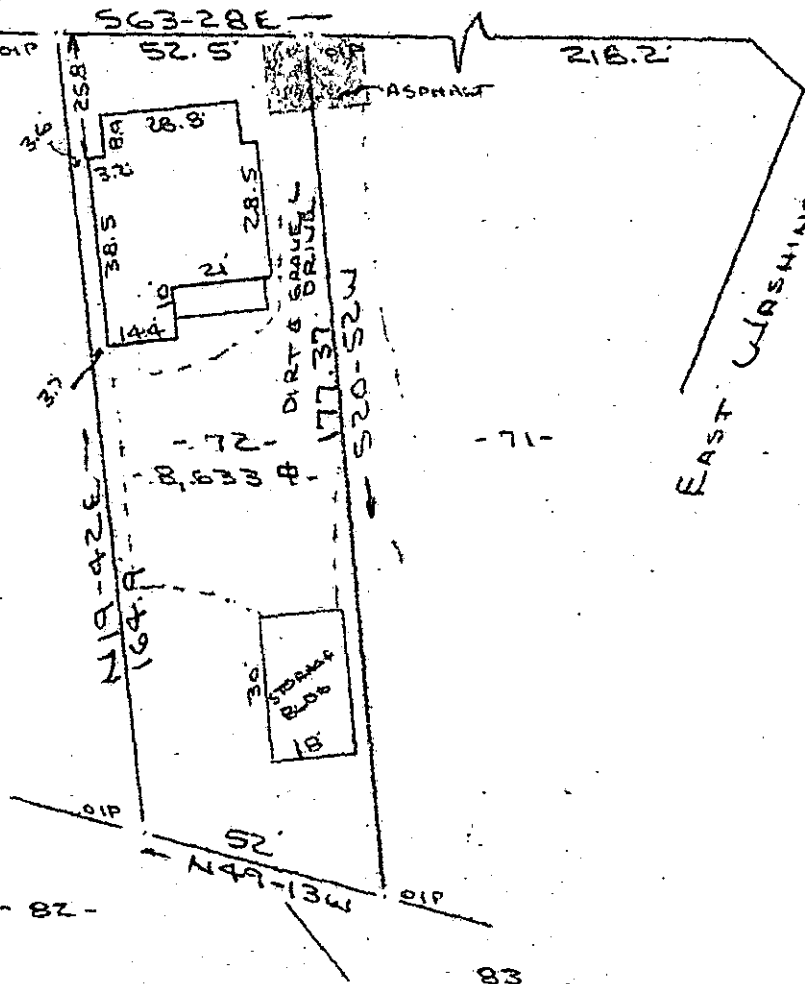

Note:  
Improvements on this  
lot are not in a  
flood hazard area.

PROPERTY OF  
L. S. SPINKS  
GREENVILLE COUNTY, GREENVILLE, S.C.  
22 MAR 1984

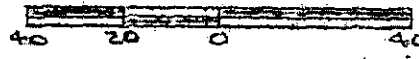

This is to certify that on the 22nd day of March, 1984, I surveyed the property shown on this plat, being known as lot 72 on plat of BLOCK " F " MAP OF EAST PARK - PART OF BOYCE ADDITION recorded in Plat Book " A " at Page 383; and also known as PROPERTY OF L. S. SPINKS and recorded in Plat Book " " at Page ; and that the property lines, walls and buildings are as shown hereon, and that the walls and buildings located on said lot do not encroach or project on adjacent street or property, and that no adjacent walls or buildings encroach or project on said premises, and no power lines cross this property except as shown hereon.

MAR 26 1984

10-L-14

R. B. Bruges  
SOUTH CAROLINA  
REGISTERED  
SURVEYOR  
# 1952

29625 V

CAROLINA SURVEYING CO.  
112 Manly St.  
Greenville, S.C. 29625

Recordable Plat

5-2 MR26 84 143

3.00CI