


FILED
GREENVILLE CO. S.C.

MAR 29 10 39 AM '84

DONNIE S. TANKERSLEY
R.M.C.

MAR 29 1984

Magnetic

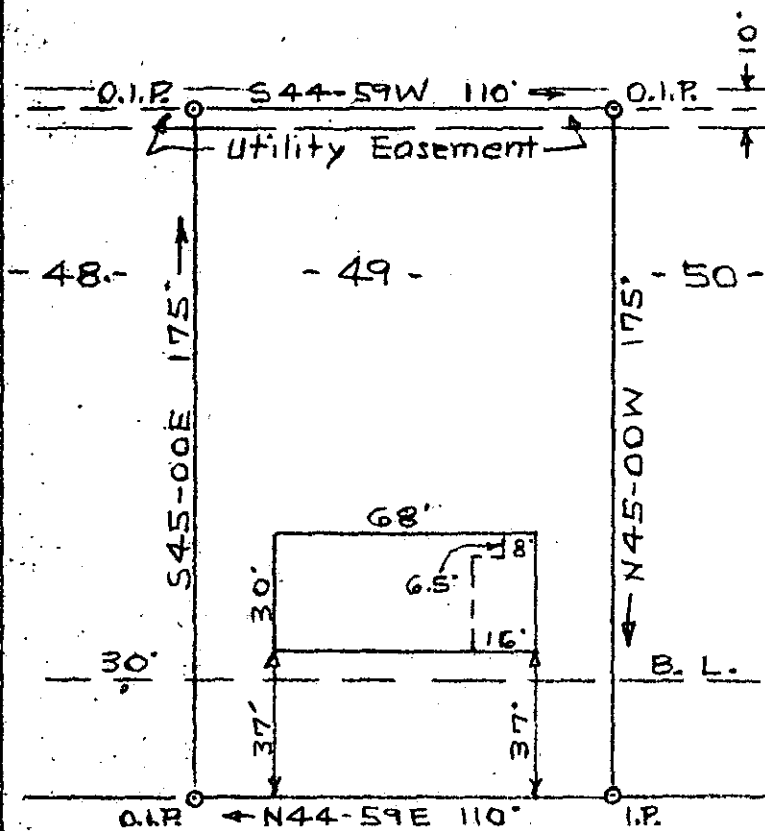

Arrowood Court
Water and sewer in St. R/W


Adams Mill Road

PLOT PLAN
HEARTHSIDE HOMES INC.
GREENVILLE CO. MAULDIN, S. C.

Scale 1" = 50' Dec. 10, 1983

T. H. Walker Jr. Reg. L. S. 3182


300 Maple Dr. Mauldin S. C.

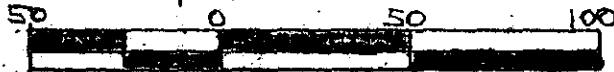

Error of closure exceeds 1/2500

30156

10. 2. 24

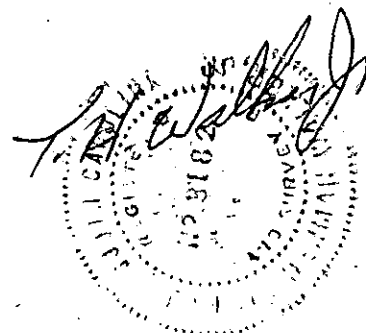

1081 11801