



MICROFILMED

DOUGLAS & ADA G. GREEN

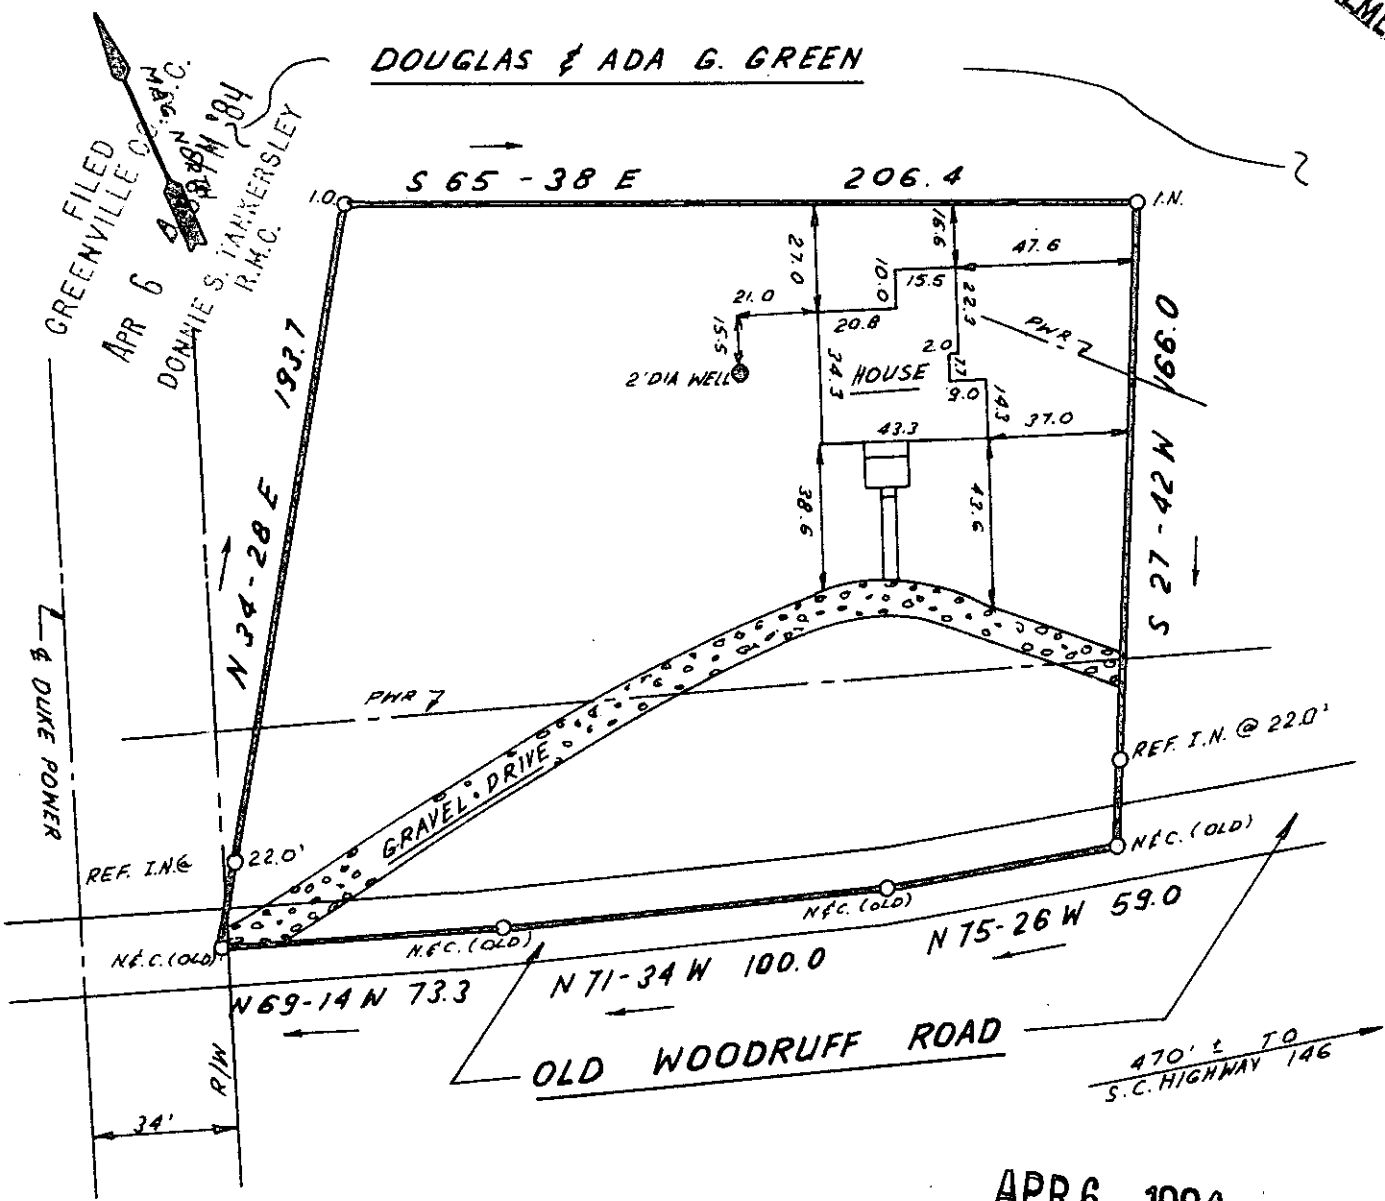

APR 6 1984

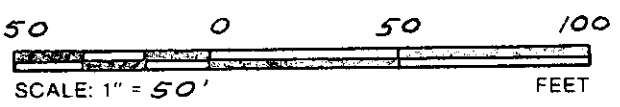

10L-71 31276

THIS IS TO CERTIFY THAT THE PROPERTY SHOWN ON THIS PLAT WAS SURVEYED UNDER MY DIRECT SUPERVISION. PROPERTY LINES AND IMPROVEMENTS SHOWN ARE LOCATED CORRECTLY AND THAT NO VISIBLE ENCROACHMENTS EXIST UNLESS OTHERWISE SHOWN. THIS PROPERTY IS NOT LOCATED IN A DESIGNATED FLOOD HAZARD AREA.

STATE OF SOUTH CAROLINA  
GREENVILLE COUNTY

FREELAND & ASSOCIATES  
Engineers • Land Surveyors  
318 WEST STONE AVENUE.  
GREENVILLE, S.C.  
(803) 271-4924

PROPERTY OF  
WALTER TERRY GREEN  
SHARON F. GREEN

PLAT BOOK	95 - 95
DEED BOOK	1188 - 603
TAX MAP	539.2 - 1 - 15.2
PARTY CHIEF	J.E.C.
DRAWN	B.R.
DATE	3 - 30 - 84
DWG. NO.	10816

SOUTH CAROLINA  
REGISTERED LAND SURVEYOR  
4781  
JAMES R. FREELAND

RLS: JAMES R. FREELAND  
NO: 4781

5070 - 2 AP. 6 84 1209 3.0001