


MICROFILMED


FILED
GREENVILLE CO. S.C.

APR 13 11 07 AM '84

DONNIE S. TANKERSLEY
R.M.C.

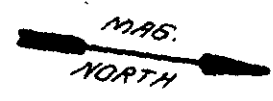

PT. 21

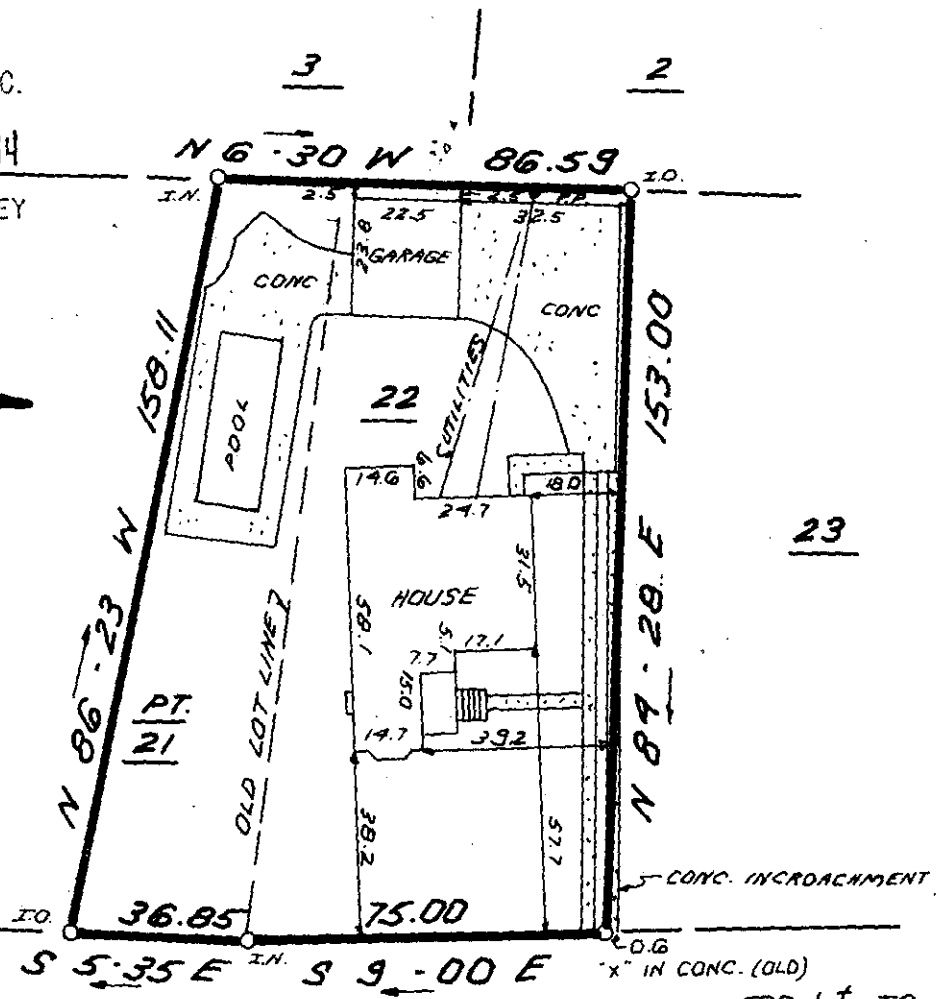

NORTH AVONDALE DRIVE

(MAPLE AVENUE)

APR 13 1984

32039

10L-89



THIS IS TO CERTIFY THAT THE PROPERTY SHOWN ON THIS PLAT WAS SURVEYED UNDER MY DIRECT SUPERVISION. PROPERTY LINES AND IMPROVEMENTS SHOWN ARE LOCATED CORRECTLY AND THAT NO VISIBLE ENCROACHMENTS EXIST UNLESS OTHERWISE SHOWN. THIS PROPERTY IS NOT LOCATED IN A DESIGNATED FLOOD HAZARD AREA.

GCTO -- 1AP13 84 1410



STATE OF SOUTH CAROLINA
GREENVILLE COUNTY

NORTHGATE
LOT 22 & PART LOT 21
PROPERTY OF
ALTON L. FINLEY
MARILYN FINLEY

FREELAND & ASSOCIATES
Engineers • Land Surveyors
318 WEST STONE AVENUE.
GREENVILLE, S.C.
(803) 271-4924

PLAT BOOK	I @ 103
DEED BOOK	1179 @ 371
TAX MAP	182-1-6
PARTY CHIEF	L.T.
DRAWN	K.E.G
DATE	4/12/84
DWG. NO.	10878