



FILED  
 GREENVILLE CO. S.C.  
 APR 16 10 32 AM '84  
 DONNIE S. BARKERSLEY  
 R.M.C.

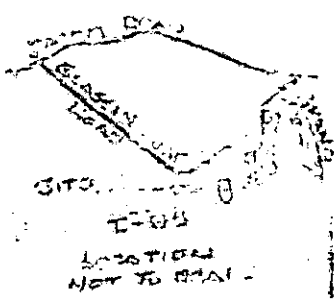

Note:  
 Improvements on this lot are not in a flood hazard area.

PROPERTY OF  
 THOMAS C. CAMPBELL, JR. & TERRY L. BUFFIN  
 NEAR GREENVILLE, GREENVILLE COUNTY, S.C.  
 6 APR 1984

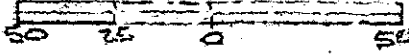

This is to certify that on the 6th day of April, 1984, I surveyed the property shown on this plat, being known as PROPERTY OF THOMAS C. CAMPBELL, JR. & TERRY L. BUFFIN and recorded in the RMC Office Greenville County, S. C., in Plat Book at Page ; and that the property lines, walls and buildings are as shown hereon, and that the walls and buildings located on said lot do not encroach or project on adjacent street or property, and that no adjacent walls or buildings encroach or project on said premises, and no power lines cross this property except as shown hereon.

10-6-96

32219

R. B. Bruce  
 R. B. Bruce, 112 1/2 Hwy 1125

APR 1 1984

1/7500  
 SURVEY

Recordable Plat

CAROLINA SURVEYING CO.  
 112 Hwy 36  
 Greenville, S. C.

GCTD 1514 3.0001