FILED
GREENVILLE CO. S. C.
APR 20 4 28 PM '84
DONNIE S. TANKERSLEY
R.M.C.

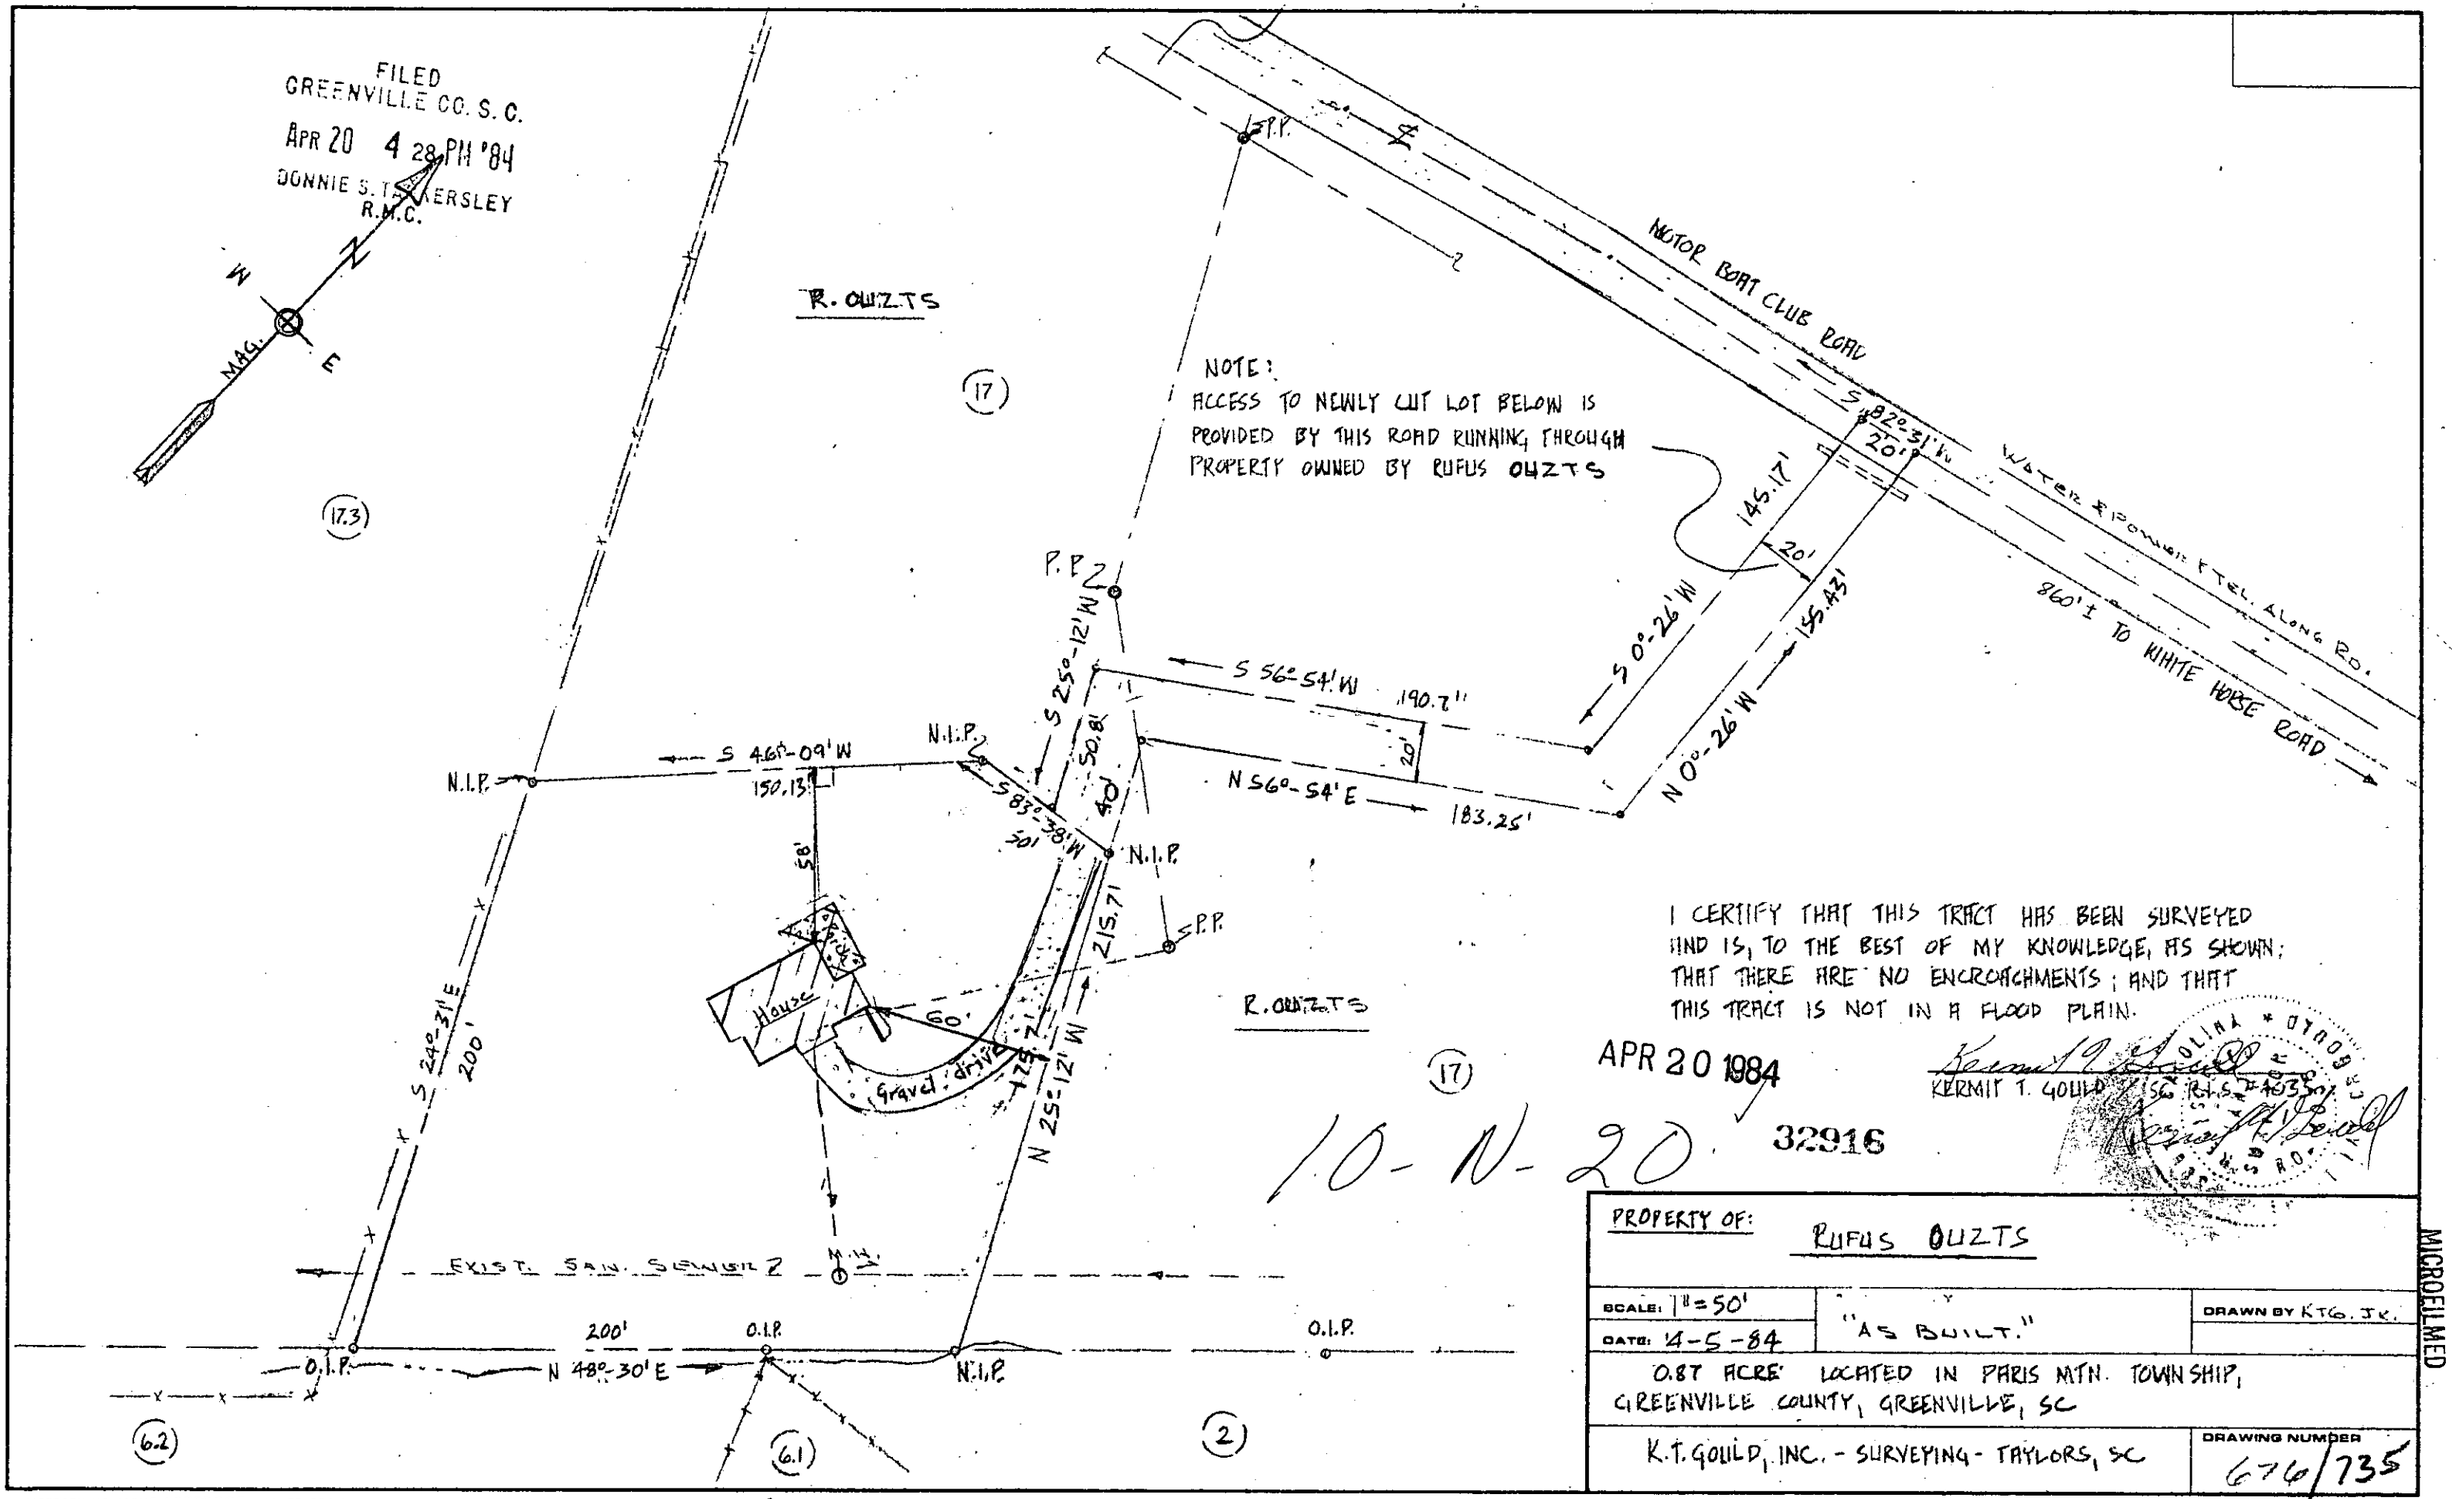

I CERTIFY THAT THIS TRACT HAS BEEN SURVEYED AND IS, TO THE BEST OF MY KNOWLEDGE, AS SHOWN; THAT THERE ARE NO ENCROACHMENTS; AND THAT THIS TRACT IS NOT IN A FLOOD PLAIN.

APR 20 1984

KERMIT T. GOULD SC R.L.S. #6350

32916

10-N-20

PROPERTY OF: RUFUS OUZTS		
SCALE: 1" = 50'	"AS BUILT."	DRAWN BY KTG. JR.
DATE: 4-5-84		
0.87 ACRE LOCATED IN PARIS MTN. TOWNSHIP, GREENVILLE COUNTY, GREENVILLE, SC		
K.T. GOULD, INC. - SURVEYING - TAYLORS, SC		DRAWING NUMBER 676/735

MICROFILMED

DIETZGEN NO 198MF AGEPROOF MASTER FORM

GCTC -----2 AP20 84 909 5.00CI