


Note:
Improvements on this lot are not in a flood hazard area.

FILED
GREENVILLE CO. S. C.
APR 19 4 15 PM '84
DONNIE S. TANKERSLEY
R.M.C.

360°
LEOPARD CTR.

STRAWBERRY DRIVE
WATER & SEWER IN ST R/W.

PROPERTY OF
DOUGLAS S. THREATT & SUSAN L. THREATT
NEAR GREENVILLE, S. C.
SCALE 1" = 40' 17 APRIL 1984

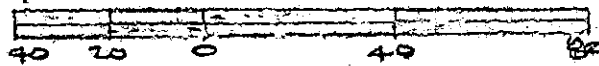

This is to certify that on the 17th day of April, 1984, I surveyed the property shown on this plat, being known as lot 27 on plat of BLUEBERRY PARK and recorded in the RMC Office Greenville County, S. C., in Plat Book "BB" at Page 18; and that the property lines, walls and buildings are as shown hereon, and that the walls and buildings located on said lot do not encroach or project on adjacent street or property, and that no adjacent walls or buildings encroach or project on said premises, and no power lines cross this property except as shown hereon.

32743 ✓

10-0-21

R. B. Bruce

R. B. Bruce, RLS #1952
40 1952

Recordable Plat

CAROLINA SURVEYING CO.
112 Manly St.
Greenville, S. C.

APR 19 1984

2 AP 19 84

700

3.00CI