MICROFILMED

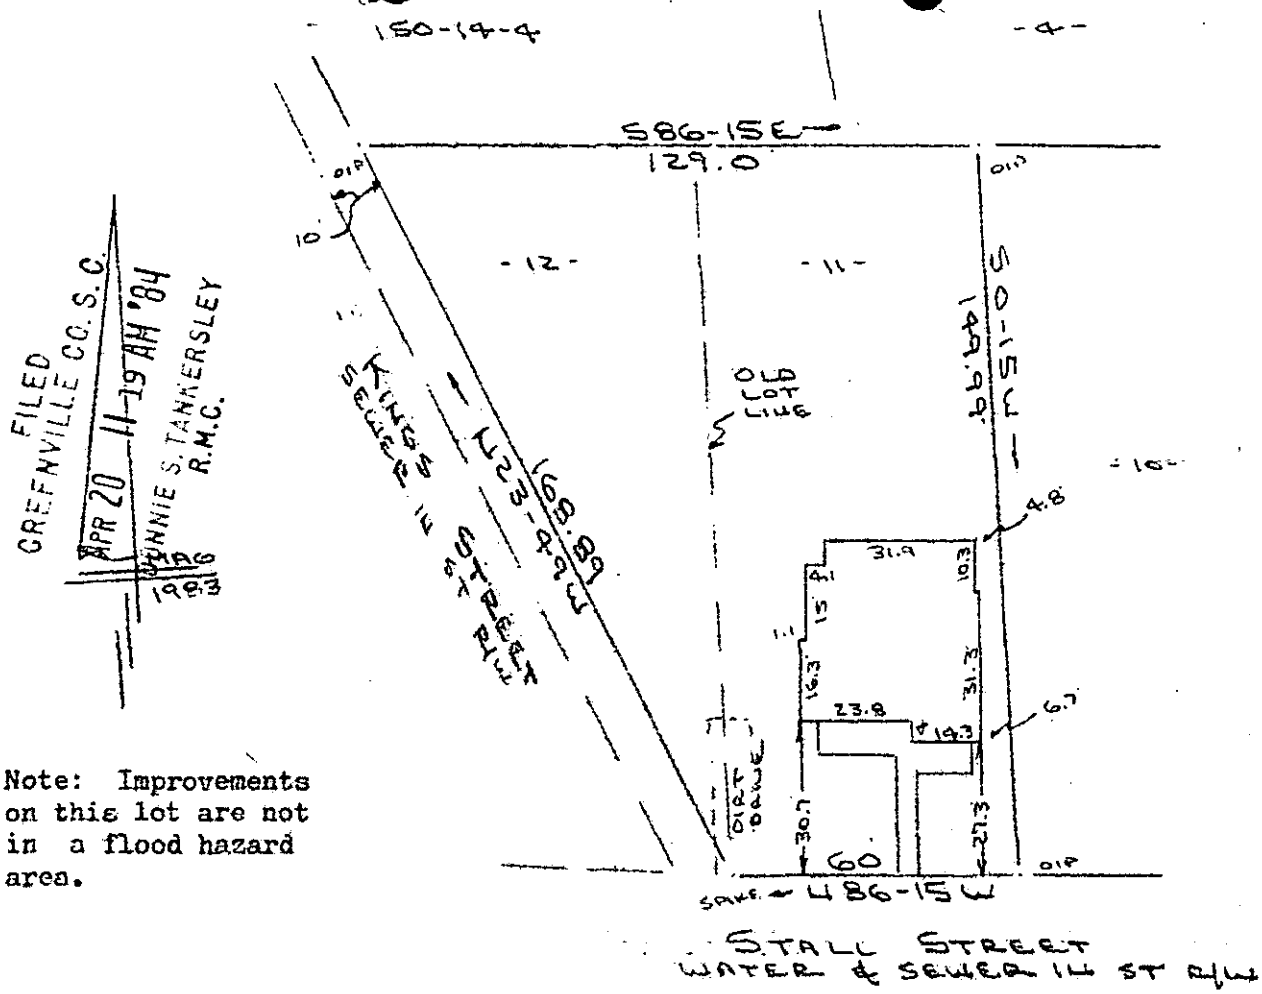

Note: Improvements on this lot are not in a flood hazard area.

PROPERTY OF
MARGARET THOMASON
GREENVILLE, S.C.
15 MAR 1984

40 20 0 40

This is to certify that on the 15th day of March, 1984, I surveyed the chown on this plat, being known as lot 11 and lot 12 on plat of PROPERTY OF ADRIAN HAYDEN & ESTHER HAYDEN and recorded in the RMC Office Greenville County, S. C., in Plat Book " 9 - Y " at Page 80; and that the property lines, walls and buildings are as shown hereon, and that the walls and buildings located on said lot do not encroach or project on adjacent street or property, and that no adjacent walls or buildings encroach or project on said premises, and no power lines cross this property except as shown hereon.

APR 20 1984

32908

R. B. Bruce

R. B. Bruce, RLS #1952

10-0-23

CAROLINA SURVEYING CO.
112 Manly St.
Greenville, S.C.

AP20'84 816

3.00CI

150-14-13