


FILED  
GREENVILLE CO. S. C.

APR 23 1 36 PM '84


-36-  
DONNIE S. TANKERSLEY  
R.M.C.

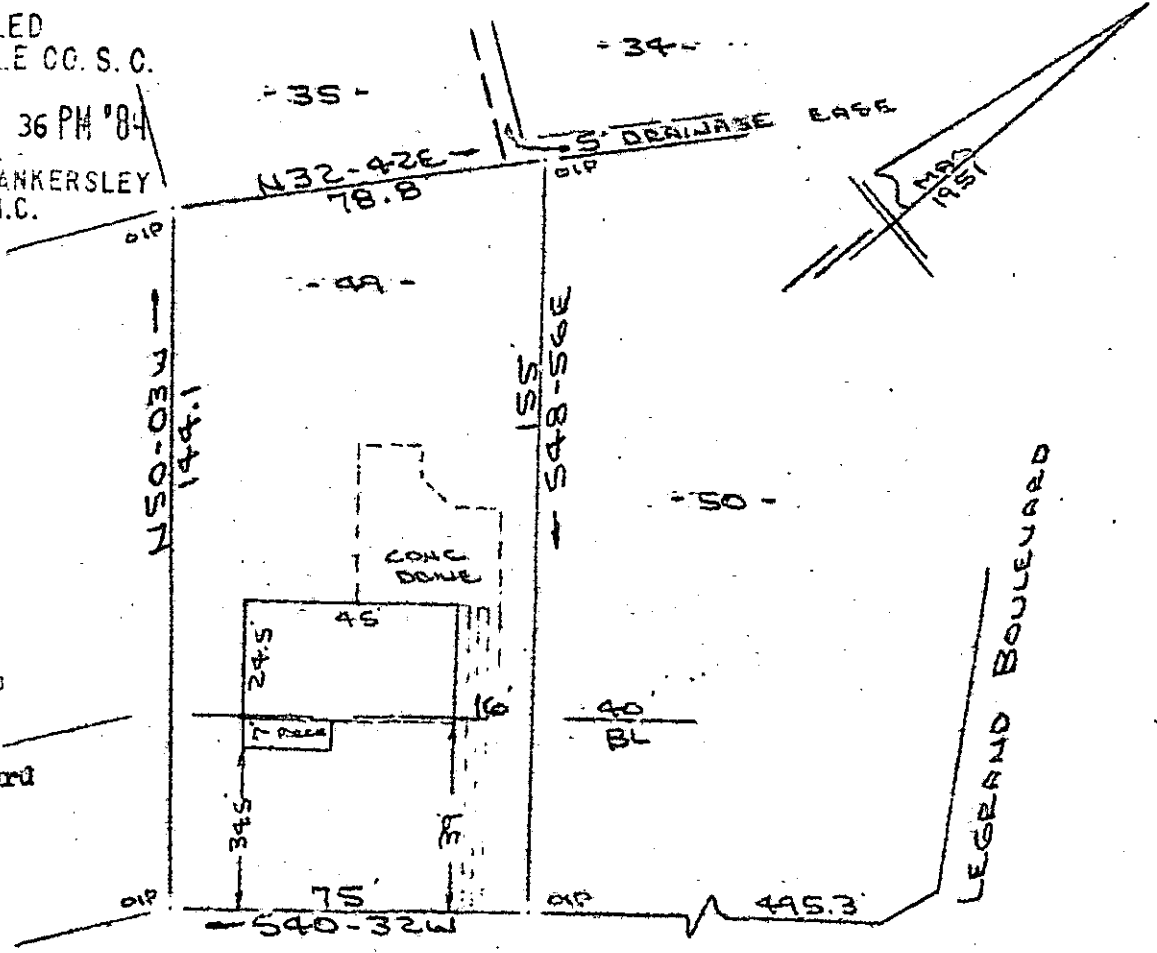

Note:  
Improvements  
on this lot  
are not in  
a flood hazard  
area.

FRIARTUCK ROAD  
WATER & SEWER IN 20' R/W

PROPERTY OF  
DAVID LEE STEWART & ELAINE H. STEWART  
GREENVILLE, S.C.  
18 APR 1984

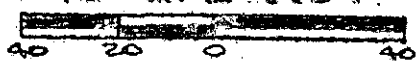

This is to certify that on the 18th day of April, 1984, I surveyed the property shown on this plat, being known as lot 49 on plat of SHERWOOD FOREST and recorded in the RMC Office Greenville County, S. C., in Plat Book "DB" at Pages 30 & 31; and that the property lines, walls and buildings are as shown hereon, and that the walls and buildings located on said lot do not encroach or project on adjacent street or property, and that no adjacent walls or buildings encroach or project on said premises, and no power lines cross this property except as shown hereon.

33069

10-0-38

R. B. Brice  
SOUTH CAROLINA  
REGISTRAR  
R. B. Brice, REG. #1952  
RECORDED  
APR 23 1984  
GREENVILLE, S. C.

Recordable Plat

APR 23 1984

CAROLINA SURVEYING CO.  
112 Manly St.  
Greenville, S. C.

GC10 -- 1 AP2384 448

3.0001