
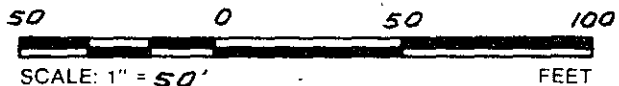


MICROFILMED

FILED
GREENVILLE CO. S.C.
APR 25 11:59 AM '84
DONNIE S. TANKERSLEY
R.M.C.

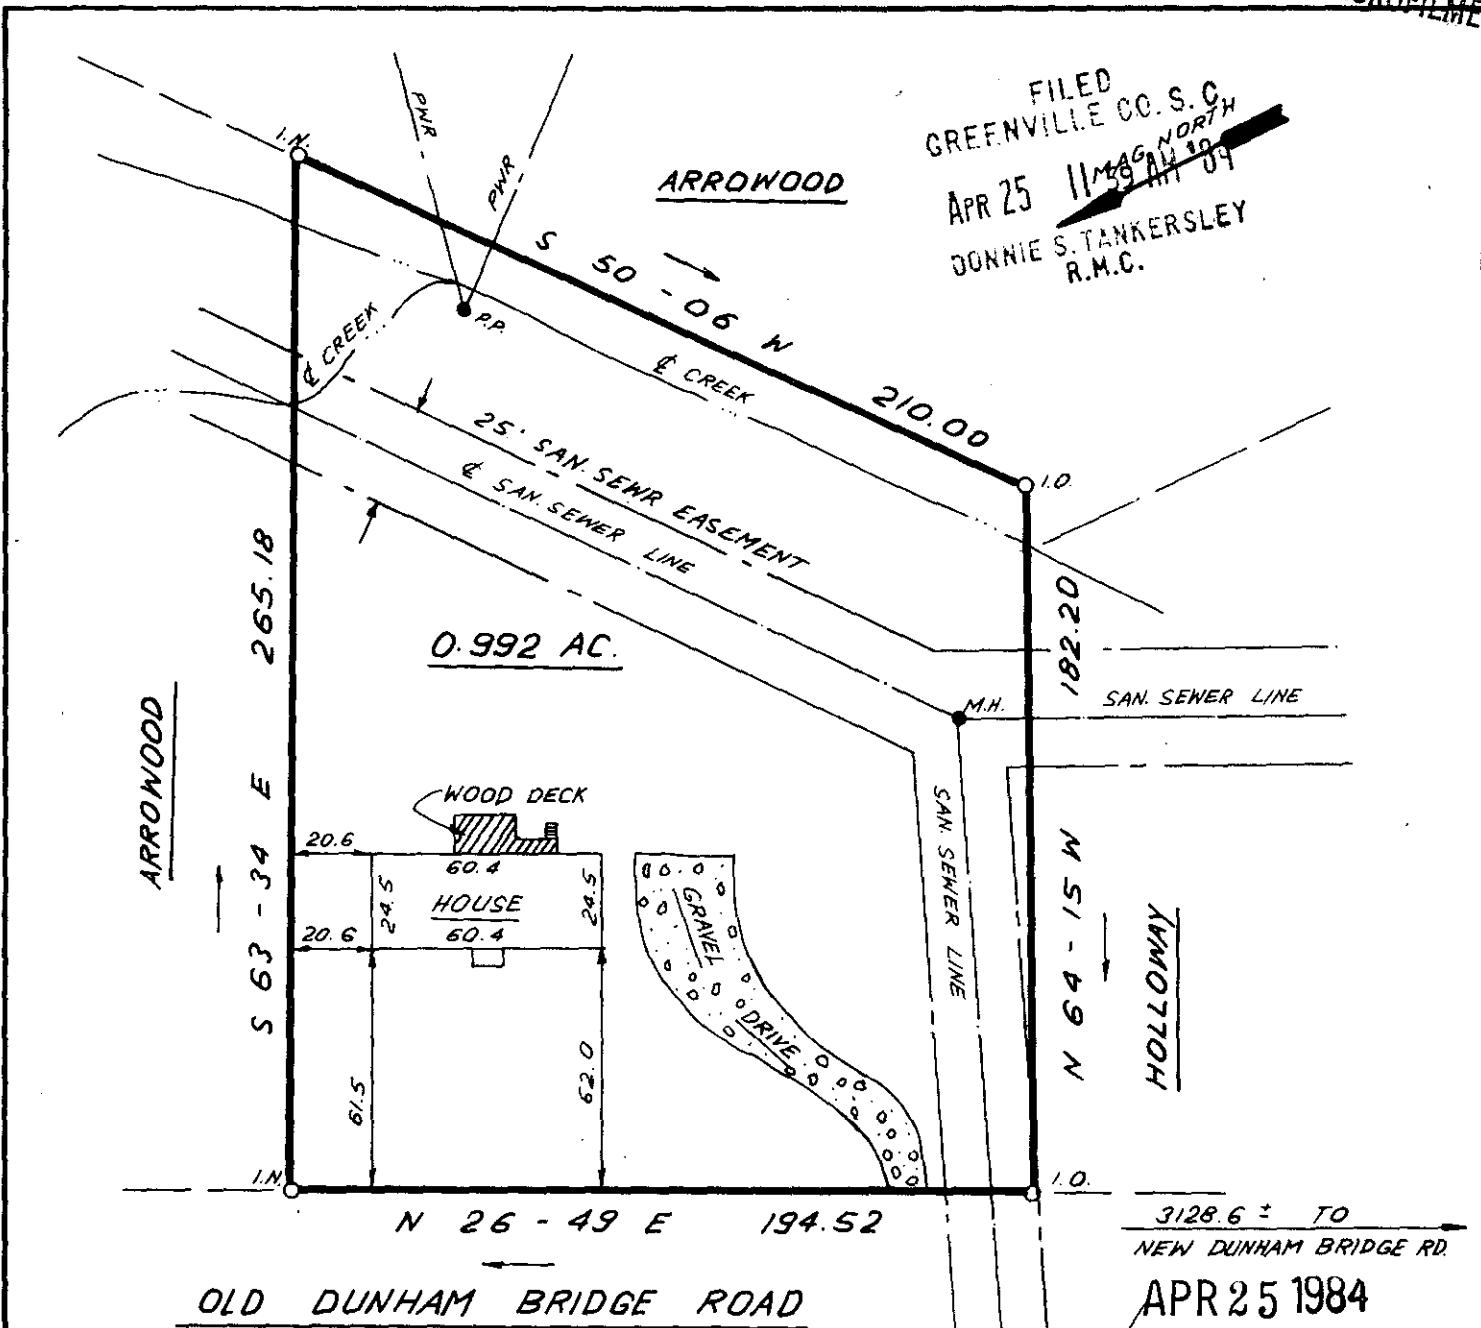


3128.6 ± TO
NEW DUNHAM BRIDGE RD.

APR 25 1984
33265

10-0-55

THIS IS TO CERTIFY THAT THE PROPERTY SHOWN ON THIS PLAT WAS SURVEYED UNDER MY DIRECT SUPERVISION. PROPERTY LINES AND IMPROVEMENTS SHOWN ARE LOCATED CORRECTLY AND THAT NO VISIBLE ENCROACHMENTS EXIST UNLESS OTHERWISE SHOWN. THIS PROPERTY IS NOT LOCATED IN A DESIGNATED FLOOD HAZARD AREA.

300 8 00X
1801

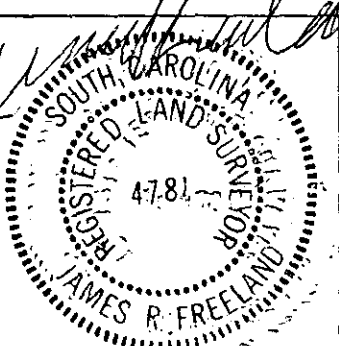

**STATE OF SOUTH CAROLINA
GREENVILLE COUNTY**

**JAMES B. ARROWOOD PROPERTY
PROPERTY OF
LARRY KEITH ARROWOOD
TAMMIE F. ARROWOOD**

FREELAND & ASSOCIATES
Engineers • Land Surveyors
318 WEST STONE AVENUE.
GREENVILLE, S.C.
(803) 271-4924

PLAT BOOK	5C - 40
DEED BOOK	1073 - 347
TAX MAP	243-2-110
PARTY CHIEF	J.E.C.
DRAWN	B.R.
DATE	4-10-84
DWG. NO.	10864

RLS: **JAMES R. FREELAND**
NO: **4781**