


SUNBELT PROPERTY

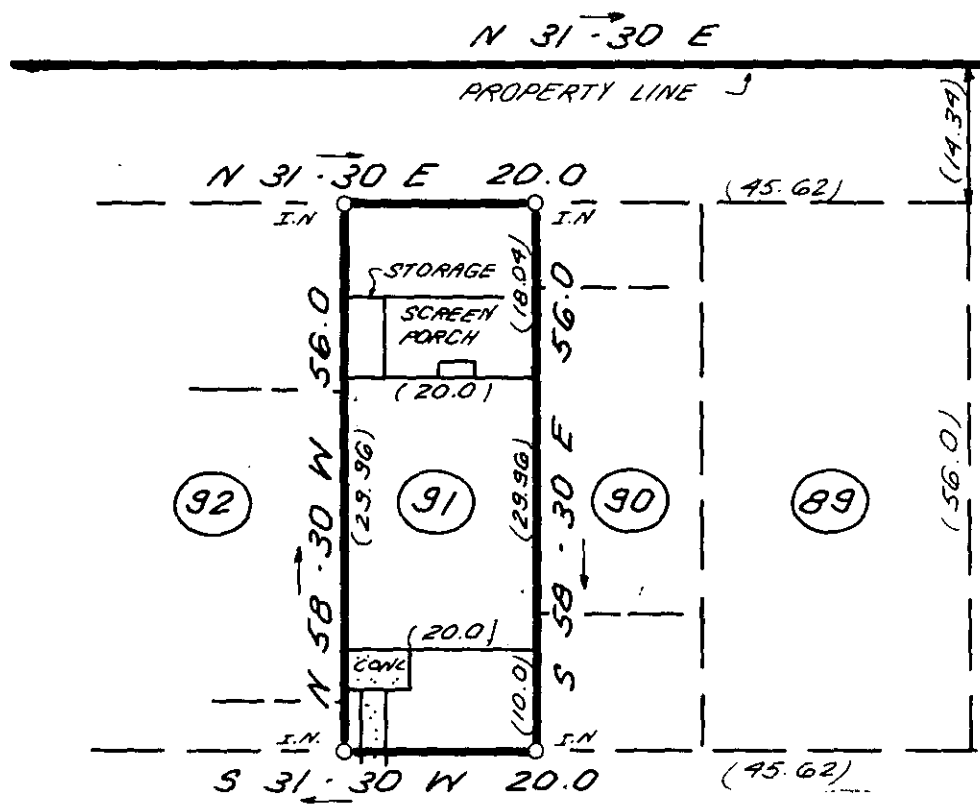

FILED
 GREENVILLE CO. S.C.
 MAY 1 4 14 PM '84
 DONNIE S. TANKERSLEY
 R.M.C.



MAY 2 1984 ✓ 34204

10-0-90

THIS IS TO CERTIFY THAT THE PROPERTY SHOWN ON THIS PLAT WAS SURVEYED UNDER MY DIRECT SUPERVISION. PROPERTY LINES AND IMPROVEMENTS SHOWN ARE LOCATED CORRECTLY AND THAT NO VISIBLE ENCROACHMENTS EXIST UNLESS OTHERWISE SHOWN. THIS PROPERTY IS NOT LOCATED IN A DESIGNATED FLOOD HAZARD AREA

STATE OF SOUTH CAROLINA
 GREENVILLE COUNTY

FREELAND & ASSOCIATES
 Engineers • Land Surveyors
 318 WEST STONE AVENUE.
 GREENVILLE, S.C.
 (803) 271-4924



JAMESTOWNE II
UNIT 91
 PROPERTY OF
PATRICIA ANN POOLE

PLAT BOOK	9W - 33
DEED BOOK	
TAX MAP	
PARTY CHIEF	B.H.
DRAWN	K.E.G.
DATE	4/27/84
PLAT NO.	10988000D

RLS: JAMES R. FREELAND
 NO: 4781

CTD ----- 3 MY01 84