
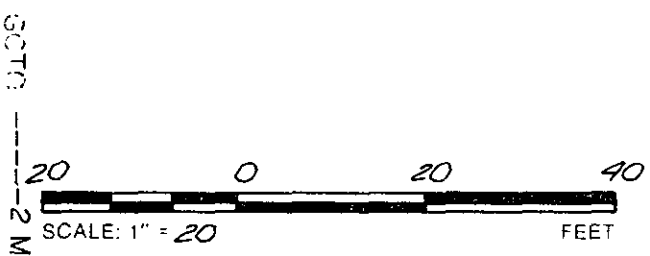


MICROFILMED

FILED
GREENVILLE CO. S.C.
MAY 4 11 49 AM '84
DONNIE S. TANKERSLEY
R.M.C.

SUNBELT
PROPERTIES

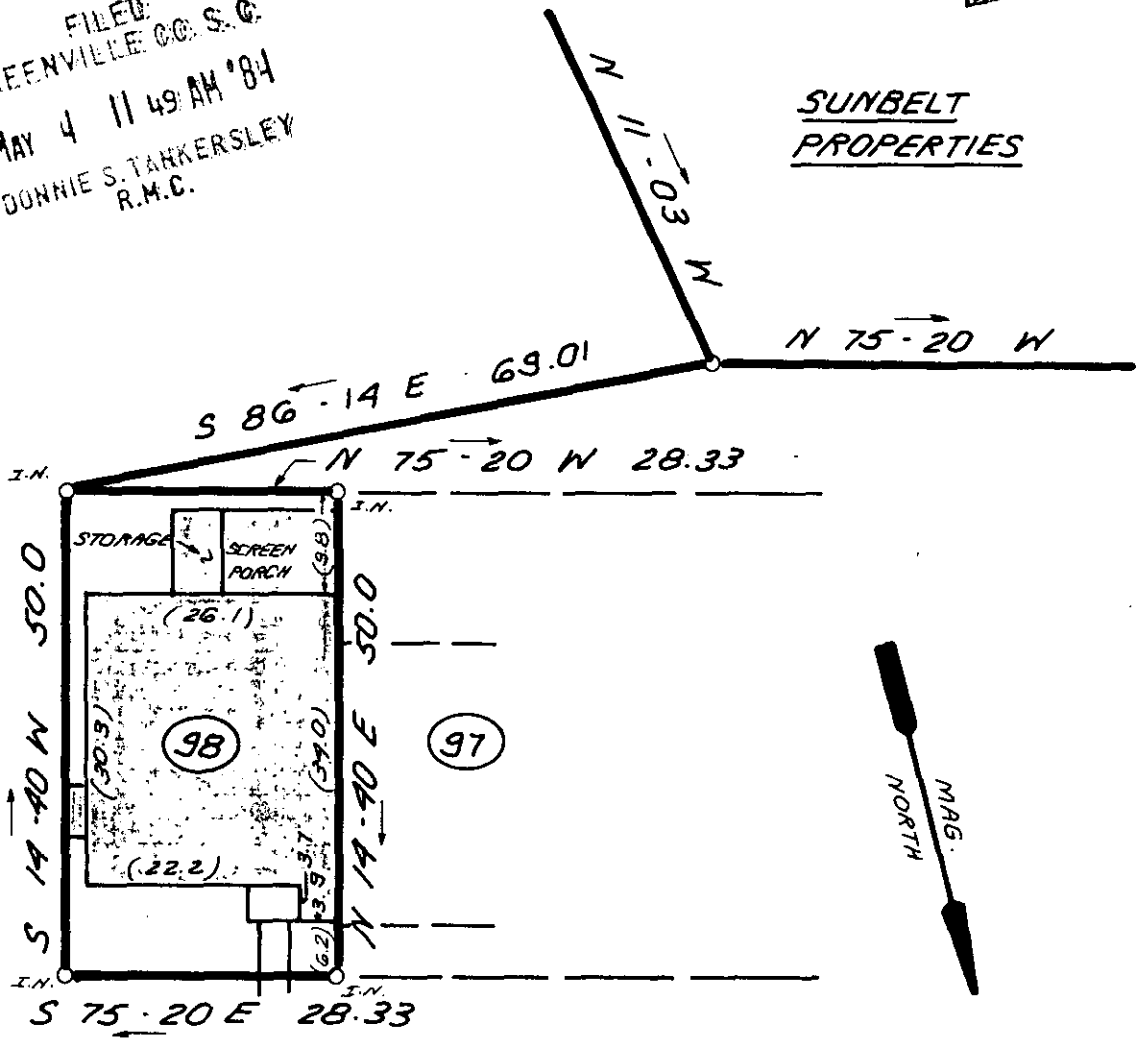

31695

10-P. 9 MAY 4 1984

THIS IS TO CERTIFY THAT THE PROPERTY SHOWN ON THIS PLAT WAS SURVEYED UNDER MY DIRECT SUPERVISION. PROPERTY LINES AND IMPROVEMENTS SHOWN ARE LOCATED CORRECTLY AND THAT NO VISIBLE ENCROACHMENTS EXIST UNLESS OTHERWISE SHOWN. THIS PROPERTY IS NOT LOCATED IN A DESIGNATED FLOOD HAZARD AREA.

773 	STATE OF SOUTH CAROLINA GREENVILLE COUNTY	FREELAND & ASSOCIATES Engineers • Land Surveyors 318 WEST STONE AVENUE. GREENVILLE, S.C. (803) 271-4924
	<u>JAMESTOWNE II</u> <u>UNIT 98</u> <u>PROPERTY OF</u> <u>KEITH R. WAGGONER</u>	PLAT BOOK <u>9W-33</u> DEED BOOK TAX MAP PARTY CHIEF <u>J.E.C.</u> DRAWN <u>K.E.G.</u> DATE <u>5-1-84</u> DWG. NO. <u>11009</u>

mc