MICROFILMED

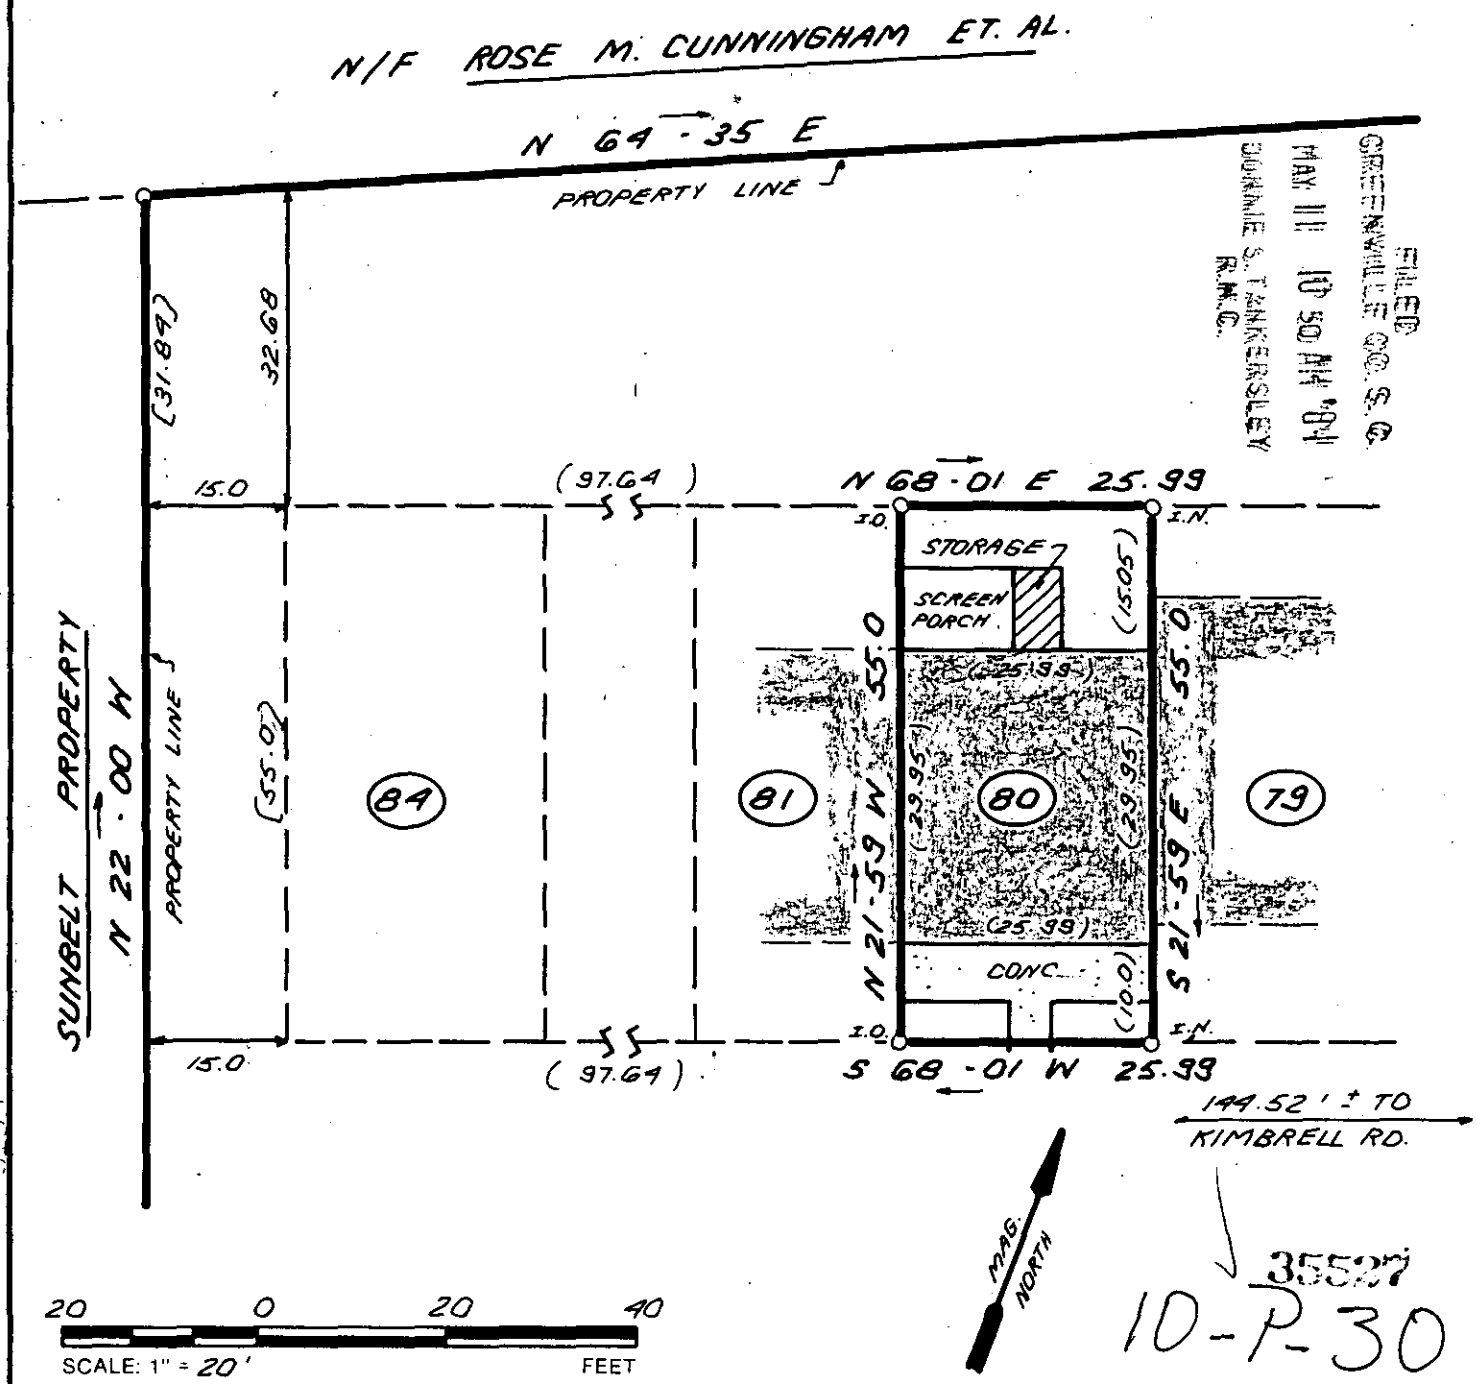

35527

10-P-30

THIS IS TO CERTIFY THAT THE PROPERTY SHOWN ON THIS PLAT WAS SURVEYED UNDER MY DIRECT SUPERVISION. PROPERTY LINES AND IMPROVEMENTS SHOWN ARE LOCATED CORRECTLY AND THAT NO VISIBLE ENCROACHMENTS EXIST UNLESS OTHERWISE SHOWN. THIS PROPERTY IS NOT LOCATED IN A DESIGNATED FLOOD HAZARD AREA.

SOUTH CAROLINA REGISTERED LAND SURVEYOR 8809

W. B. Huntley III

RLS: W.B. HUNTLEY III

NO: 8809

STATE OF SOUTH CAROLINA
GREENVILLE COUNTY

JAMESTOWNE II

UNIT 80

PROPERTY OF

MANUELA K. LOSCHNER

FREELAND & ASSOCIATES
Engineers • Land Surveyors
318 WEST STONE AVENUE.
GREENVILLE, S.C.
(803) 271-4924

PLAT BOOK	9W · 33
DEED BOOK	
TAX MAP	
PARTY CHIEF	W. B. H. III
DRAWN	K.E.G.
DATE	MAY 5, 1984
DWG. NO.	11063

THE PRINT MACHINE, INC. N37703