MICROFILMED

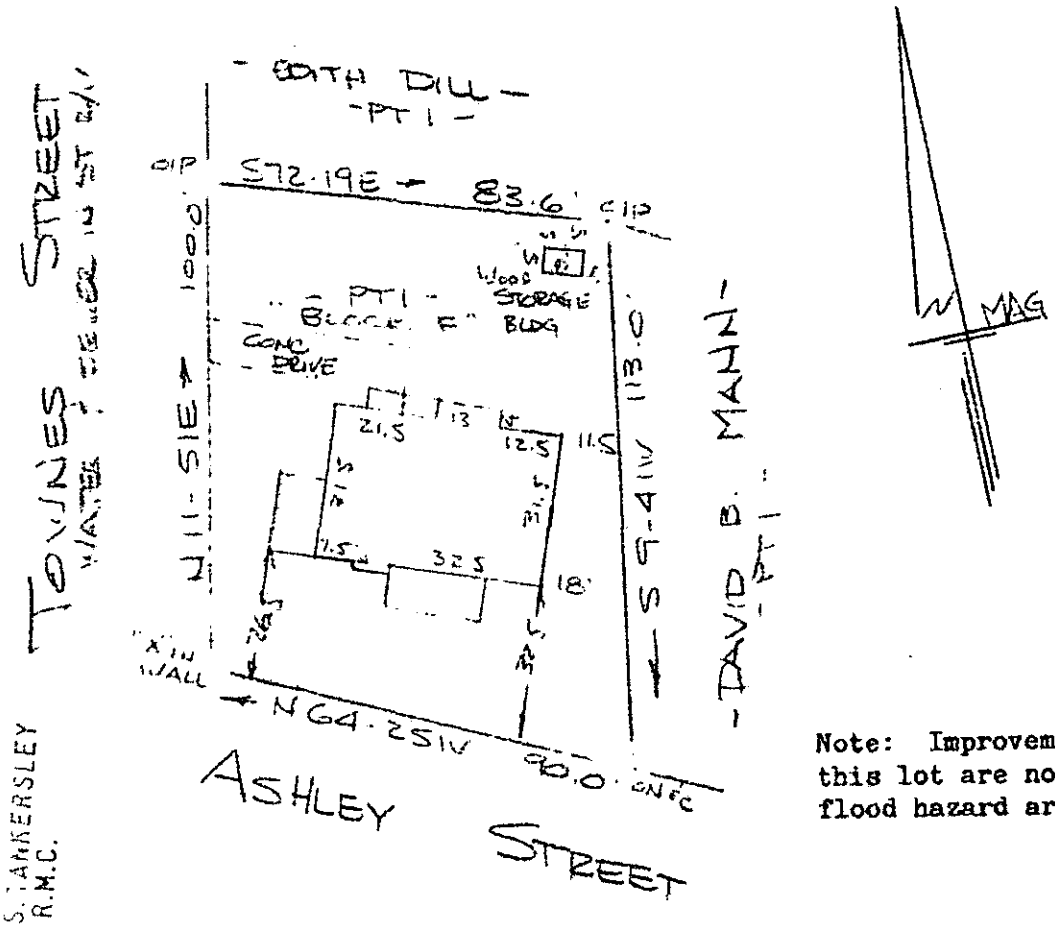

Note: Improvements on this lot are not in a flood hazard area.

FILED
GREENVILLE CO. S. C.
MAY 30 3 52 PM '84
DONNIE S. TANKERSLEY
R.M.C.

PROPERTY OF
JEFFREY A. WILLIAMS
GREENVILLE SC
SCALE: 1" = 40'
22 MAY 1984

This is to certify that on the 22nd day of May, 1984, I surveyed the property shown on this plat, being known as part of lot 1 Block " F " on plat of BUIST CIRCLE and recorded in the RMC Office Greenville County, S. C., in Plat Book " C " at Page 10 and also known as PROPERTY OF JEFFREY A. WILLIAMS and recorded in Plat Book at Page ; and that the property lines, walls and buildings are as shown hereon, and that the walls and buildings located on said lot do not encroach or project on adjacent street or property, and that no adjacent walls or buildings encroach or project on said premises, and no power lines cross this property except as shown hereon.

10-R-25 37697

R. B. Bruce, RLS #1952

SOUTH CAROLINA REGISTERED PROFESSIONAL ENGINEER

CAROLINA SURVEYING CO.
112 Manly St.
Greenville, S. C.

Recordable Plat

MAY 30 1984

2 MY30'84 1290

3.00CI

275/3 178-11-1.1 9.