


CAMPBELL STREET
WATER & SEWER 14 ST. R.W.


FILED
GREENVILLE CO. S.C.
MAY 31 10 52 AM '84
R.M.C.
S. HARRISLEY

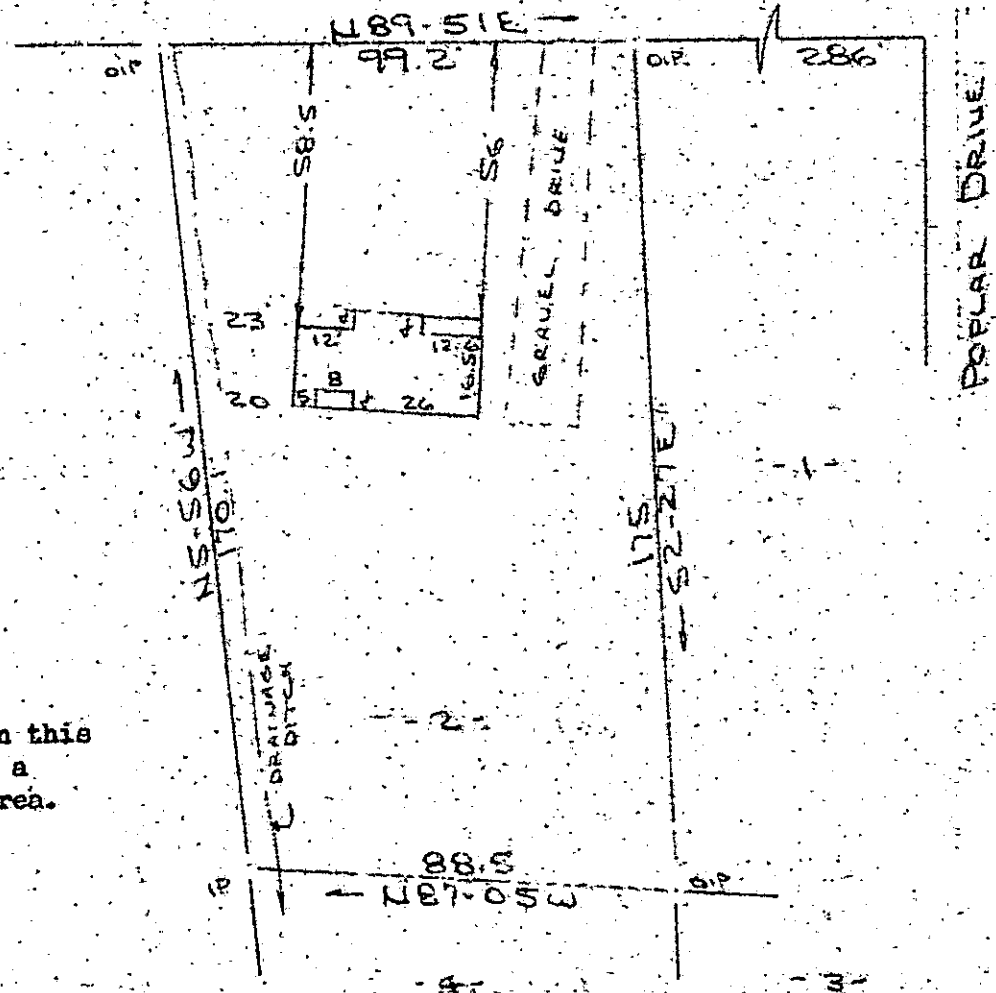

G 2 - 3 - 221

Note:
Improvements on this lot are not in a flood hazard area.

PROPERTY OF
JAMES A. FULD
GREENVILLE COUNTY, GREENVILLE, S.C.
7 MAY 1984

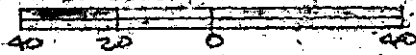

This is to certify that on the 7th day of May, 1984, I surveyed the property shown on this plat, being known as lot 2 on plat of PROPERTY OF HENDRIX R. PLUMLEY ESTATE and recorded in the RMC Office Greenville County, S. C., in Plat Book "WW" at Page 95; and that the property lines, walls and buildings are as shown hereon, and that the walls and buildings located on said lot do not encroach or project on adjacent street or property, and that no adjacent walls or buildings encroach or project on said premises, and no power lines cross this property except as shown hereon.

MAY 31 1984 ✓ 10-R-30
37816

R. B. Bruce, RLS #1952
RECORDABLE PLAT

CAROLINA SURVEYING CO. 112 Manly St. Greenville, S.C. 27410
MAY 31 84 004
3.0000