


MICROFILMED

FILED
GREENVILLE CO. S.C.
JUN 5 10 23 AM '84
DORINE S. THOMPSON
R.M.C.

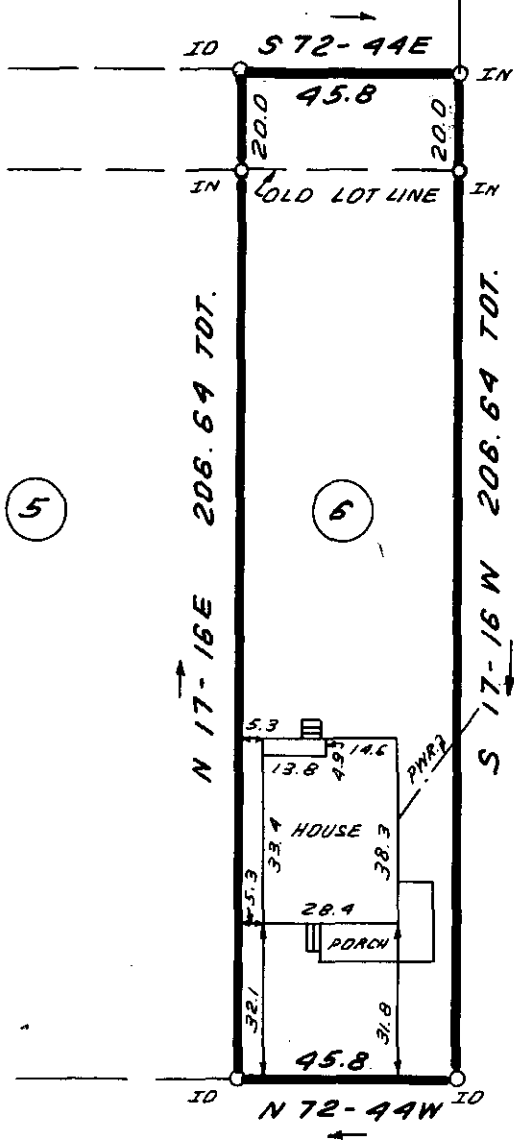

JUN 5 1984

DOUTHIT STREET


✓ 38514

10 R-65



THIS IS TO CERTIFY THAT THE PROPERTY SHOWN ON THIS PLAT WAS SURVEYED UNDER MY DIRECT SUPERVISION. PROPERTY LINES AND IMPROVEMENTS SHOWN ARE LOCATED CORRECTLY AND THAT NO VISIBLE ENCROACHMENTS EXIST UNLESS OTHERWISE SHOWN. THIS PROPERTY IS NOT LOCATED IN A DESIGNATED FLOOD HAZARD AREA.

3008
31801

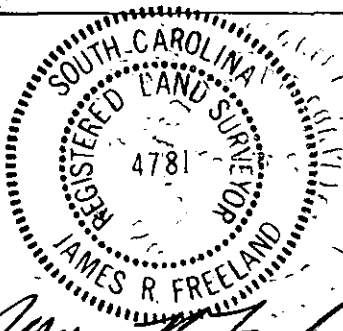

**STATE OF SOUTH CAROLINA
GREENVILLE COUNTY**

FREELAND & ASSOCIATES
Engineers • Land Surveyors
318 WEST STONE AVENUE.
GREENVILLE, S.C.
(803) 271-4924

O.K. & J. Mc H. MAULDIN

LOT 6

PROPERTY OF

KITTY SUE BOWEN RATLIFF ^{62A}

PLAT BOOK	F - 237
DEED BOOK	1203 - 869
TAX MAP	76.2-1-18
PARTY CHIEF	R. J.
DRAWN	B. R.
DATE	5-25-84
DWG. NO.	11, 158

RLS: JAMES R. FREELAND
NO: 4781