


MICROFILMED

FILED GREENVILLE CO. S.C.


JUN 5 3 53 PM '84

Note: Improvements on this lot are not in a flood hazard area.

DONNIE S. TANKERSLEY R.M.C.

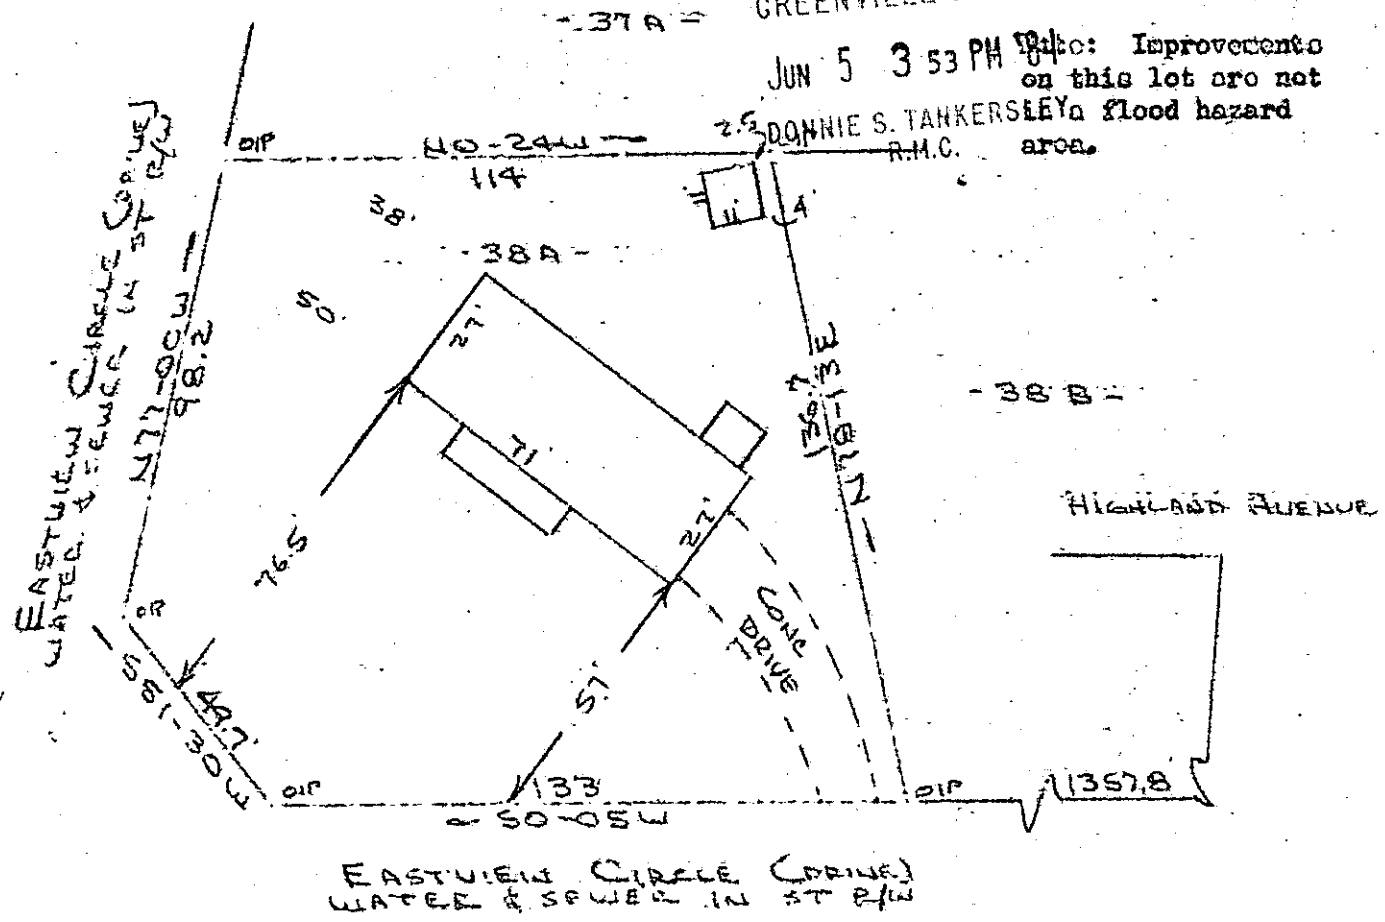

PROPERTY OF
BILLIE S. BUCHANAN
 GREENVILLE COUNTY, SIMPSONVILLE, S.C.
 30 MAY 1984

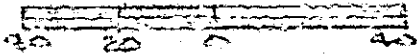

This is to certify that on the 30th day of May, 1984, I surveyed the property shown on this plat, being known as lot 38 - A on plat of PROPERTY OF BILLIE S. BUCHANAN and recorded in the RMC Office Greenville County, S. C., in Plat Book _____ at Page _____; and that the property lines, walls and buildings are as shown hereon, and that the walls and buildings located on said lot do not encroach or project on adjacent street or property, and that no adjacent walls or buildings encroach or project on said parcel, and no power lines cross this property except as shown hereon.

JUN 5 1984

38559

R. B. Brutto
 R. B. Brutto, RLS # 1952

10 R-68

CAROLINA SURVEYING CO.
 112 Manly St.
 Greenville, S. C.

Recordable Plat

3.00 8 1801