
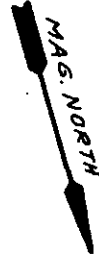


MICROFILMED

20

GREENVILLE CO. S.C.
JUN 15 2 57 PM '84
DONNIE S. TANKERSLEY
R.H.C.

25

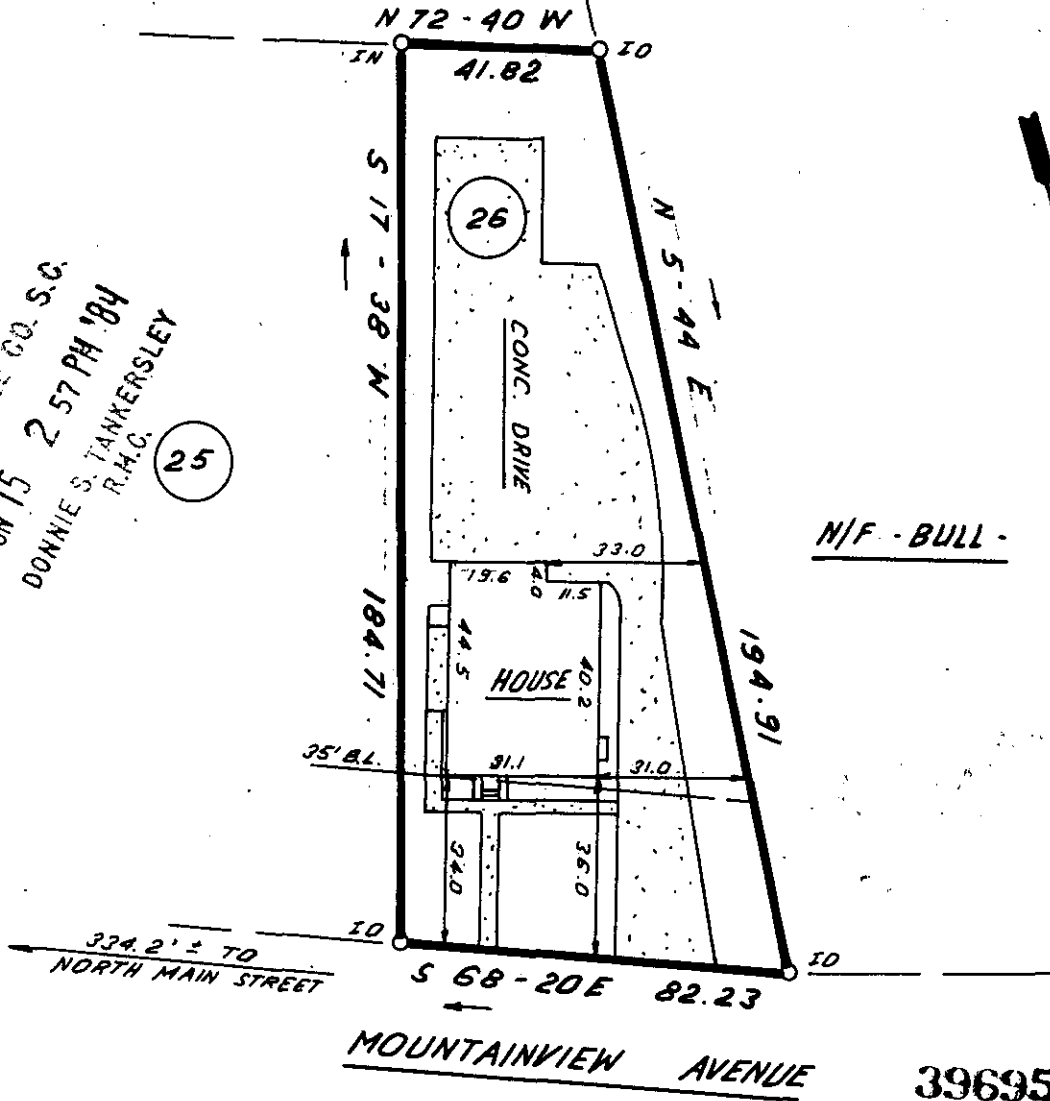

N/F - BULL -

JUN 15 1984

✓ 10-5-4



THIS IS TO CERTIFY THAT THE PROPERTY SHOWN ON THIS PLAT WAS SURVEYED UNDER MY DIRECT SUPERVISION. PROPERTY LINES AND IMPROVEMENTS SHOWN ARE LOCATED CORRECTLY AND THAT NO VISIBLE ENCROACHMENTS EXIST UNLESS OTHERWISE SHOWN. THIS PROPERTY IS NOT LOCATED IN A DESIGNATED FLOOD HAZARD AREA.

SOUTH CAROLINA
REGISTERED LAND SURVEYOR
4781
JAMES R. FREELAND
NO: 4781

**STATE OF SOUTH CAROLINA
GREENVILLE COUNTY**

NORTH PARK
LOT 26
PROPERTY OF
WILLIAM J. PIERCE
LESLIE L. PIERCE

FREELAND & ASSOCIATES
Engineers • Land Surveyors
318 WEST STONE AVENUE.
GREENVILLE, S.C.
(803) 271-4924

PLAT BOOK	K 48 - 49
DEED BOOK	388 - 223
TAX MAP	178 - 12 - 5
PARTY CHIEF	R.J.
DRAWN	B. R.
DATE	6 - 5 - 84
DWG. NO.	11, 223 - 0005