MICROFILMED

FILED
GREENVILLE CO. S.C.
JUN 19 11 46 AM '84
DONNIE S. TANKERSLEY
R.M.C.

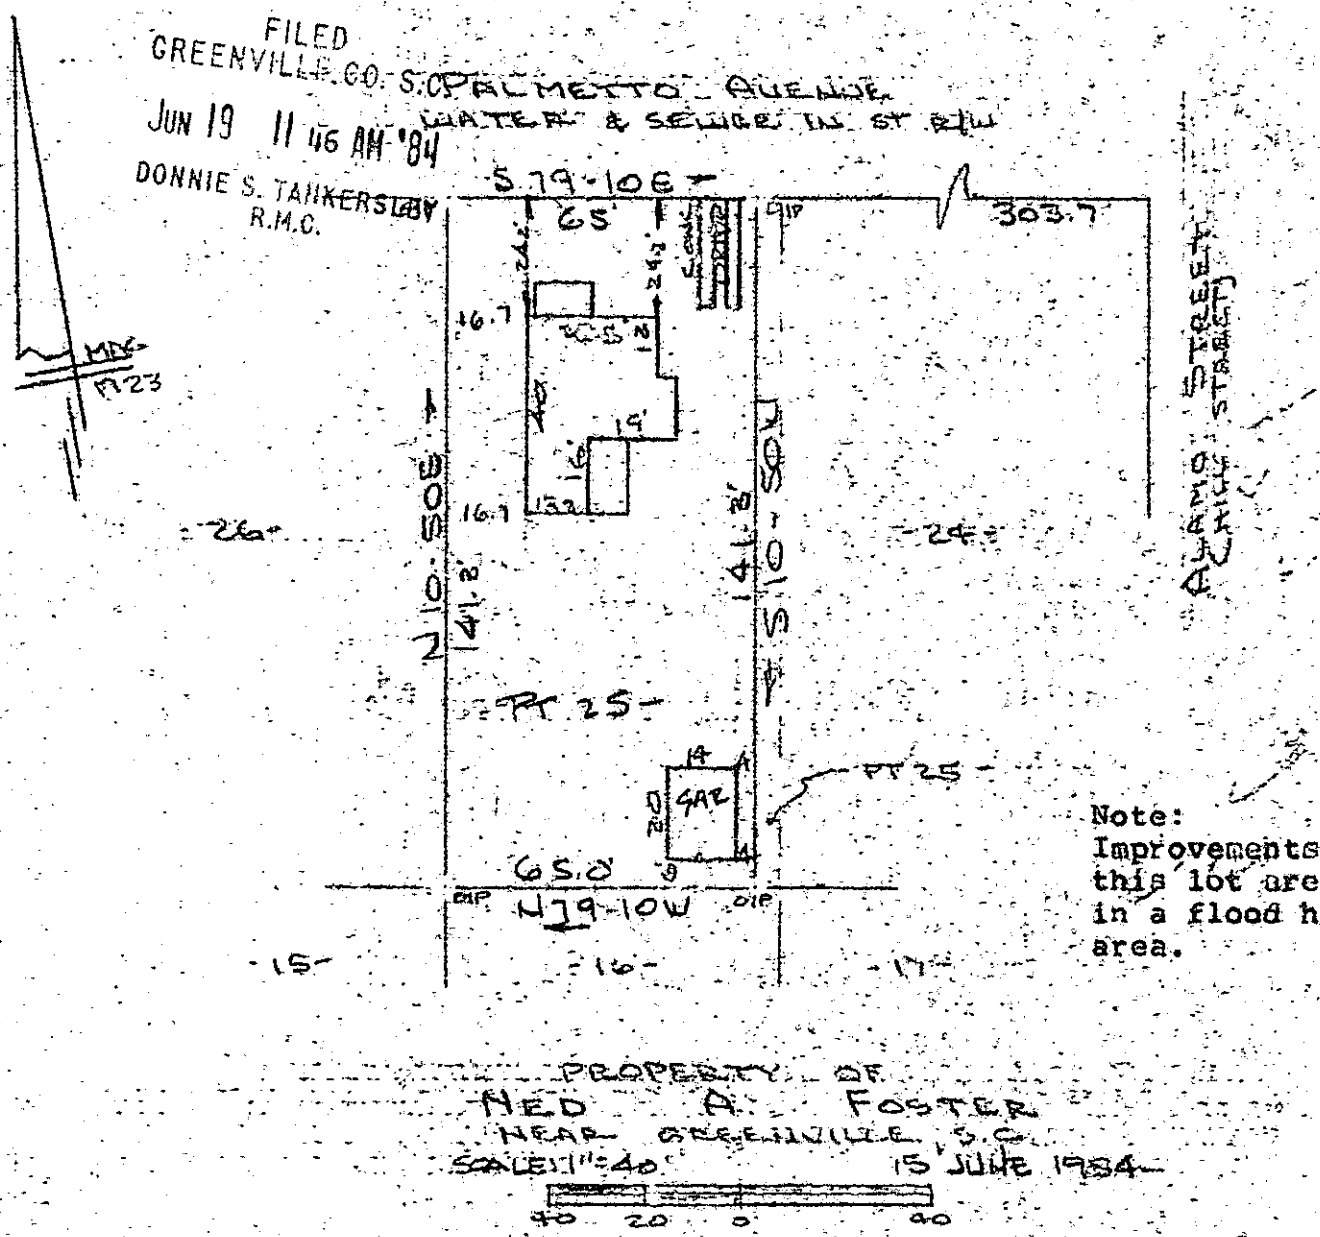

Note:
Improvements on this lot are not in a flood hazard area.

PROPERTY OF
NED A. FOSTER
NEAR GREENVILLE, S.C.
SCALE 1" = 40'
15 JUNE 1984

40 20 0 40

This is to certify that on the 15th day of June, I surveyed the property shown on this plat, being known as part of lot 25 on plat of PROPERTY OF G. J. DOUGLASS ESTATE and recorded in the RMC Office Greenville County, S. C., in Plat Book " F " at Page 126 and also known as PROPERTY OF NED A. FOSTER and recorded in Plat Book at Page ; and that the property lines, walls and buildings are as shown hereon, and that the walls and buildings located on said lot do not encroach or project on adjacent street or property, and that no adjacent walls or buildings encroach or project on said premises, and no power lines cross this property except as shown hereon.

40039

10-5-19

JUN 19 1984

R. B. Bruce

R. B. Bruce, RLS # 1952

CAROLINA SURVEYING CO.
112 Manly St.
Greenville, S. C.

Recordable Plat

BOOK -- JUN 19 84 1553
3.00CI