MICROFILMED
MAR 1969

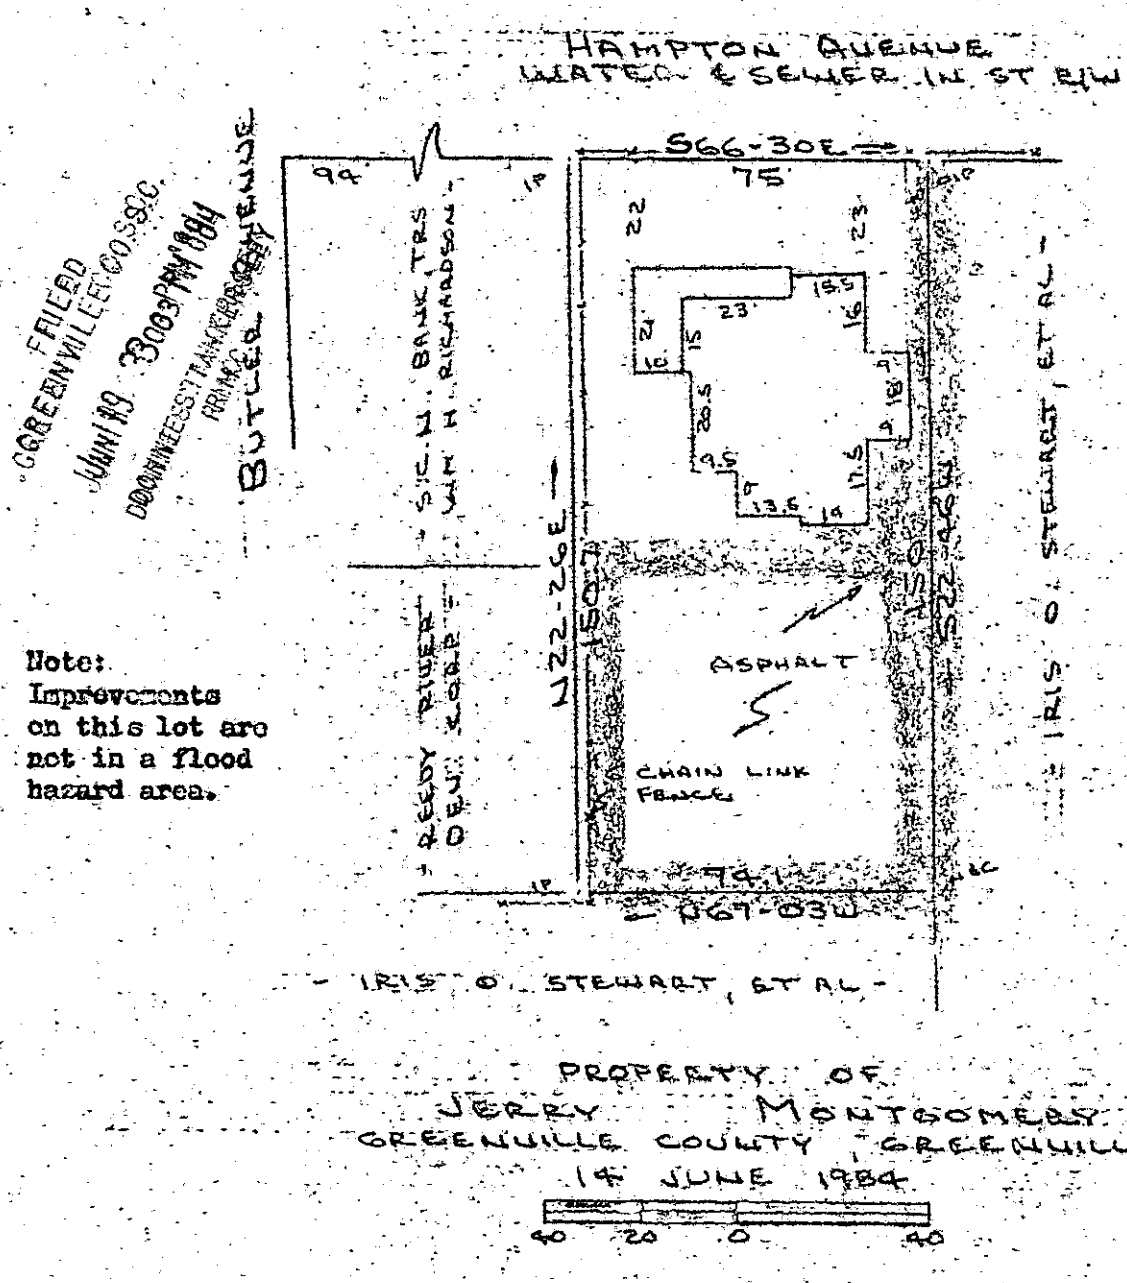
HAMPTON AVENUE
WATER & SEWER IN ST R/W
S66-30E
75
99
S.V.N. BANKTRS
J.V.N. RICHARDSON
BUTLER AVENUE
GREENVILLE FEUER
JUN 19 3 03 PM 1984
N22-20E
REEDY RIVER
ASPHALT
CHAIN LINK FENCE
IRIS O. STEWART, ET AL
99
N67-30W
IRIS O. STEWART, ET AL
22
23
15.5
16
23
22
16
15
20.5
9.5
13.6
19
17.5
18
9
4
10
10
10