


MAULDIN ROAD (S.C. 107)  
 (PARKINS MILL ROAD)  
 WATER IN RO Q/W

NOTE: Improvements on this lot are not in a flood hazard area.

PROPERTY OF  
 SOUTHERN PRINTING COMPANY  
 NEAR MAULDIN, GREENVILLE COUNTY, S.C.  
 1 JUNE 1984

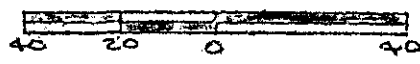

This is to certify that on the 1st day of June, 1984, I surveyed the property shown on this plat, being known as a lot on plat of PROPERTY OF SOUTHERN PRINTING COMPANY and recorded in the RMC Office Greenville, County, S. C., in PLAT BOOK " " at PAGE " " and that the property lines, walls and buildings are as shown hereon, and that the walls and buildings located on said lot do not encroach or project on adjacent street or property, and that no adjacent walls or buildings encroach or project on said premises, and no power lines cross this property except as shown hereon.

40451 10-5-29

JUN 22 1984

JAMES C. MOSELEY, JR.  
 ATTORNEY AT LAW  
 508 N. 3rd Street  
 Greenville, S.C. 29601

R. B. Bruegg, RLS # 1952

CAROLINA SURVEYING CO.  
 112 Manly St.  
 Greenville, S. C.

Recordable Plat

300 3  
 1A01