MICROFILMED

Note: Improvements on this lot are not in a flood hazard area.

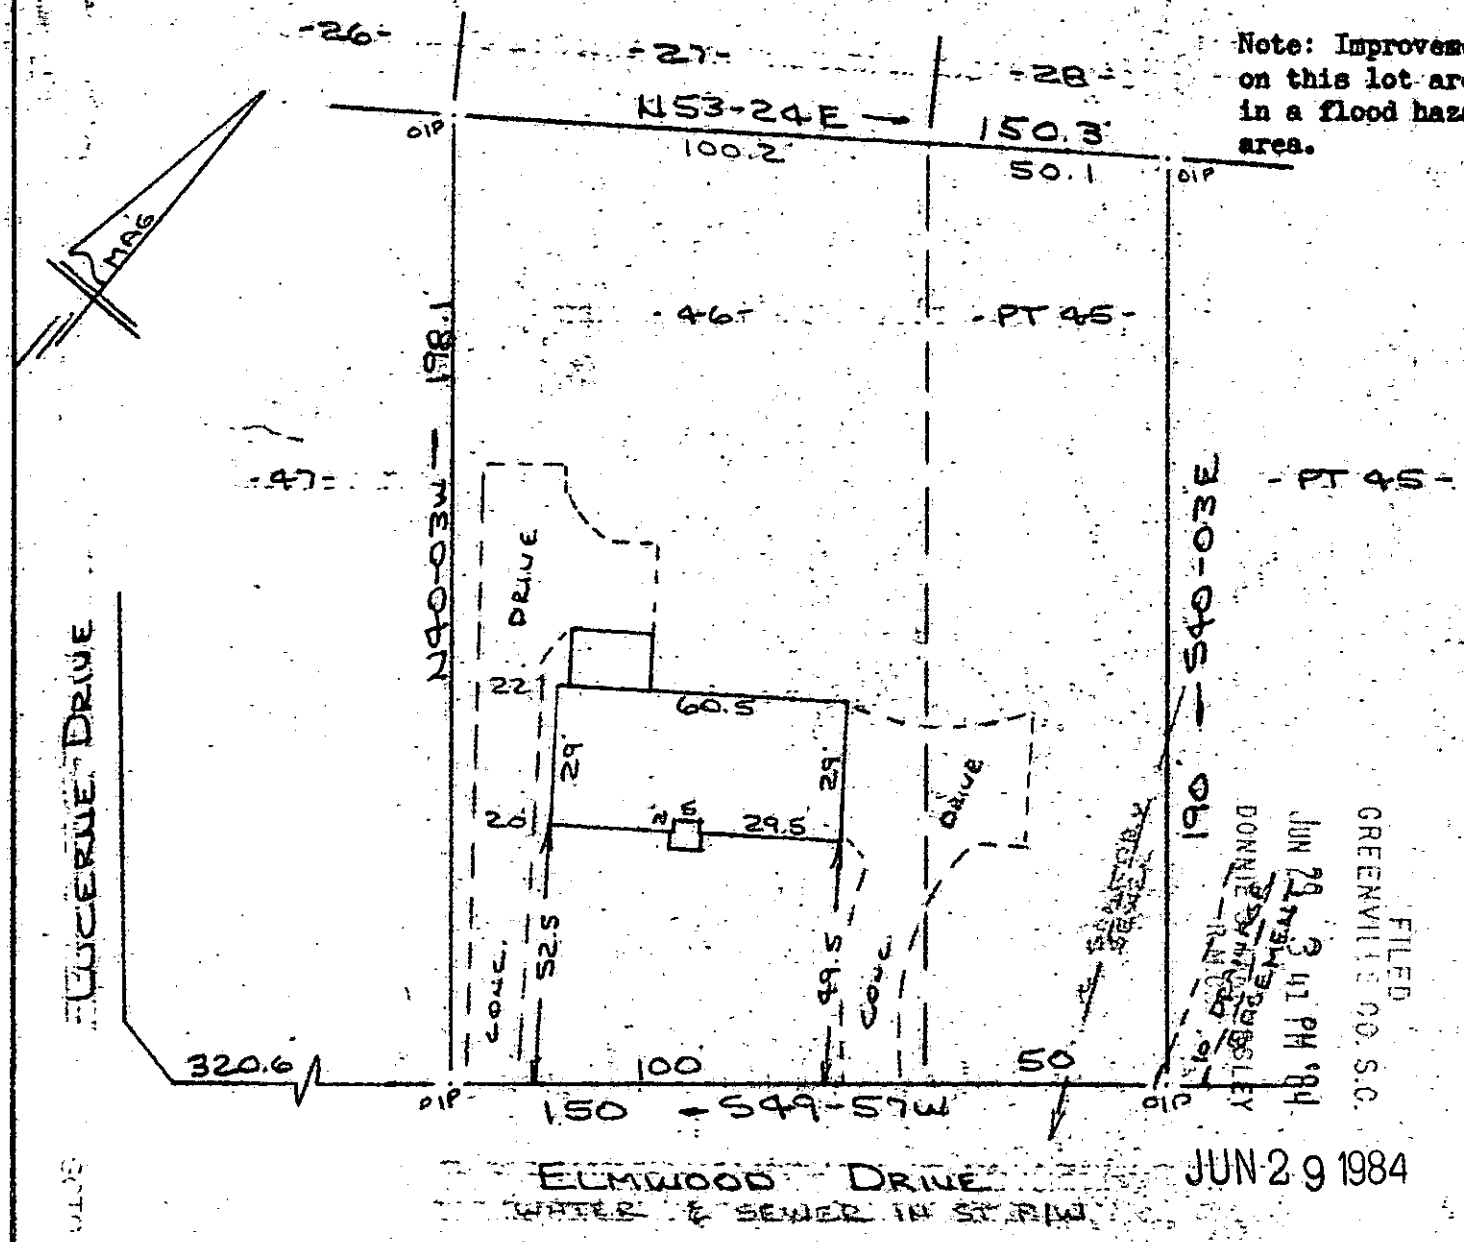

JUN 29 1984

PROPERTY OF

MAX H. ROSE & MARCIA K. ROSE

NEAR GREENVILLE, S.C.

SCALE: 1"=40' 27 JUNE 1984

This is to certify that on the 27th day of June , 1984, I surveyed the property shown on this plat, being known as lot 46 and part of lot 45 on plat of SECTION 4 EDWARDS FOREST and recorded in the RMC Office Greenville County, S. C., in Plat Book " JJJ " at Page 82 and also being known as PROPERTY OF MAX H. ROSE & MARCIA K. ROSE recorded in the RMC Office in Plat Book " " at Page ; and that the property lines, walls and buildings are as shown hereon, and that the walls and buildings located on said lot do not encroach or project on adjacent street or property, and that no adjacent walls or buildings encroach or project on said premises, and no power lines cross this property except as shown hereon.

41328

80 40 0 20 40

R. B. Bruce

R. B. Bruce, RLS #1952

Recordable Plat

CAROLINA SURVEYING CO.
112 Manly St.
Greenville, S. C.

10-S-62

STC ----2 JN29 84 1235

3.00CI