


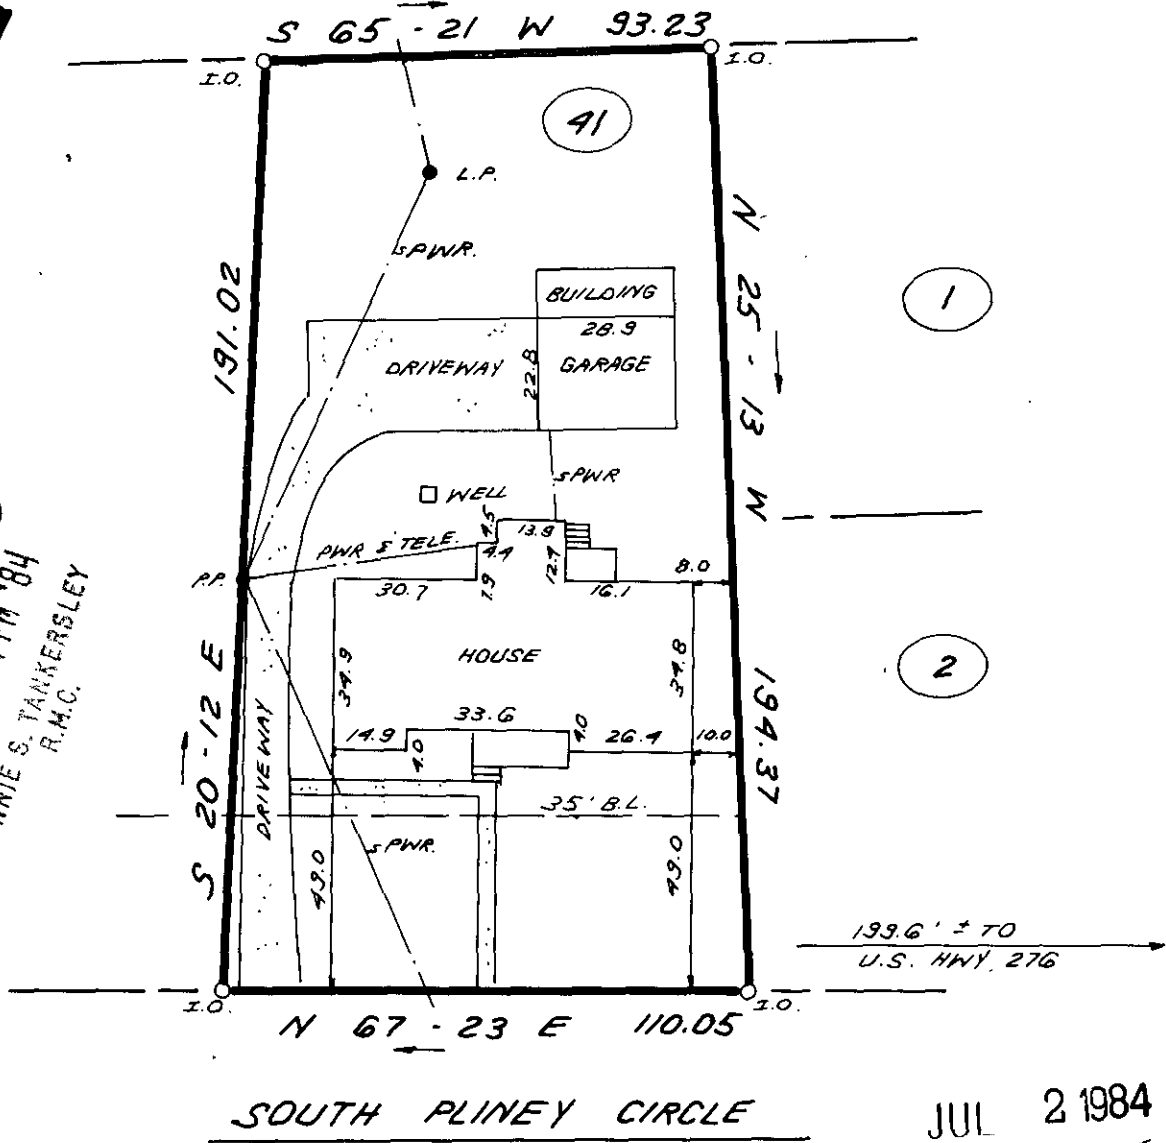


FILED  
GREENVILLE CO. S.C.  
JUL 2 4 24 PM '84  
DONNIE S. TANKERSLEY  
R.M.C.



JUL 2 1984  
10-5-74  
184

THIS IS TO CERTIFY THAT THE PROPERTY SHOWN ON THIS PLAT WAS SURVEYED UNDER MY DIRECT SUPERVISION. PROPERTY LINES AND IMPROVEMENTS SHOWN ARE LOCATED CORRECTLY AND THAT NO VISIBLE ENCROACHMENTS EXIST UNLESS OTHERWISE SHOWN. THIS PROPERTY IS NOT LOCATED IN A DESIGNATED FLOOD HAZARD AREA.

1501

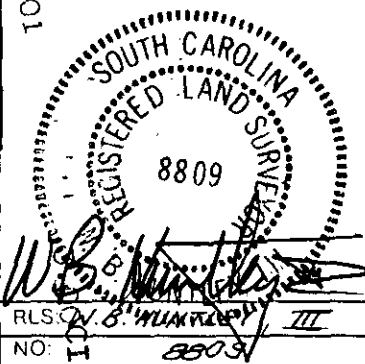

STATE OF SOUTH CAROLINA  
GREENVILLE COUNTY

FREELAND & ASSOCIATES  
Engineers • Land Surveyors  
318 WEST STONE AVENUE.  
GREENVILLE, S.C.  
(803) 271-4924

LEAGUE ESTATES  
LOT 41  
PROPERTY OF  
WILLIAM T. MILLER JR.  
SARAH W. MILLER

PLAT BOOK	K 111 - 112
DEED BOOK	391 - 107
TAX MAP	310 - 4 - 2
PARTY CHIEF	B.G.
DRAWN	K.E.G.
DATE	JUNE 26, 1984
DWG NO	11,372