
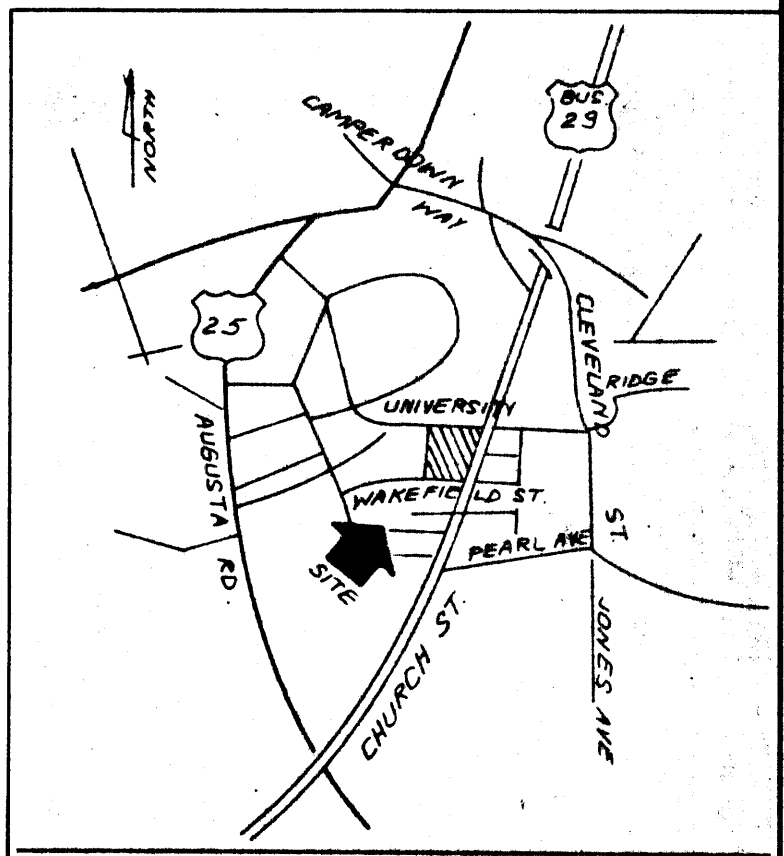


MICROFILMED


FILED  
GREENVILLE CO. S.C.  
SEP 26 4 09 PM '84  
DONNIE S. TANAERSLEY  
R.M.C.

L.S. SPINKS

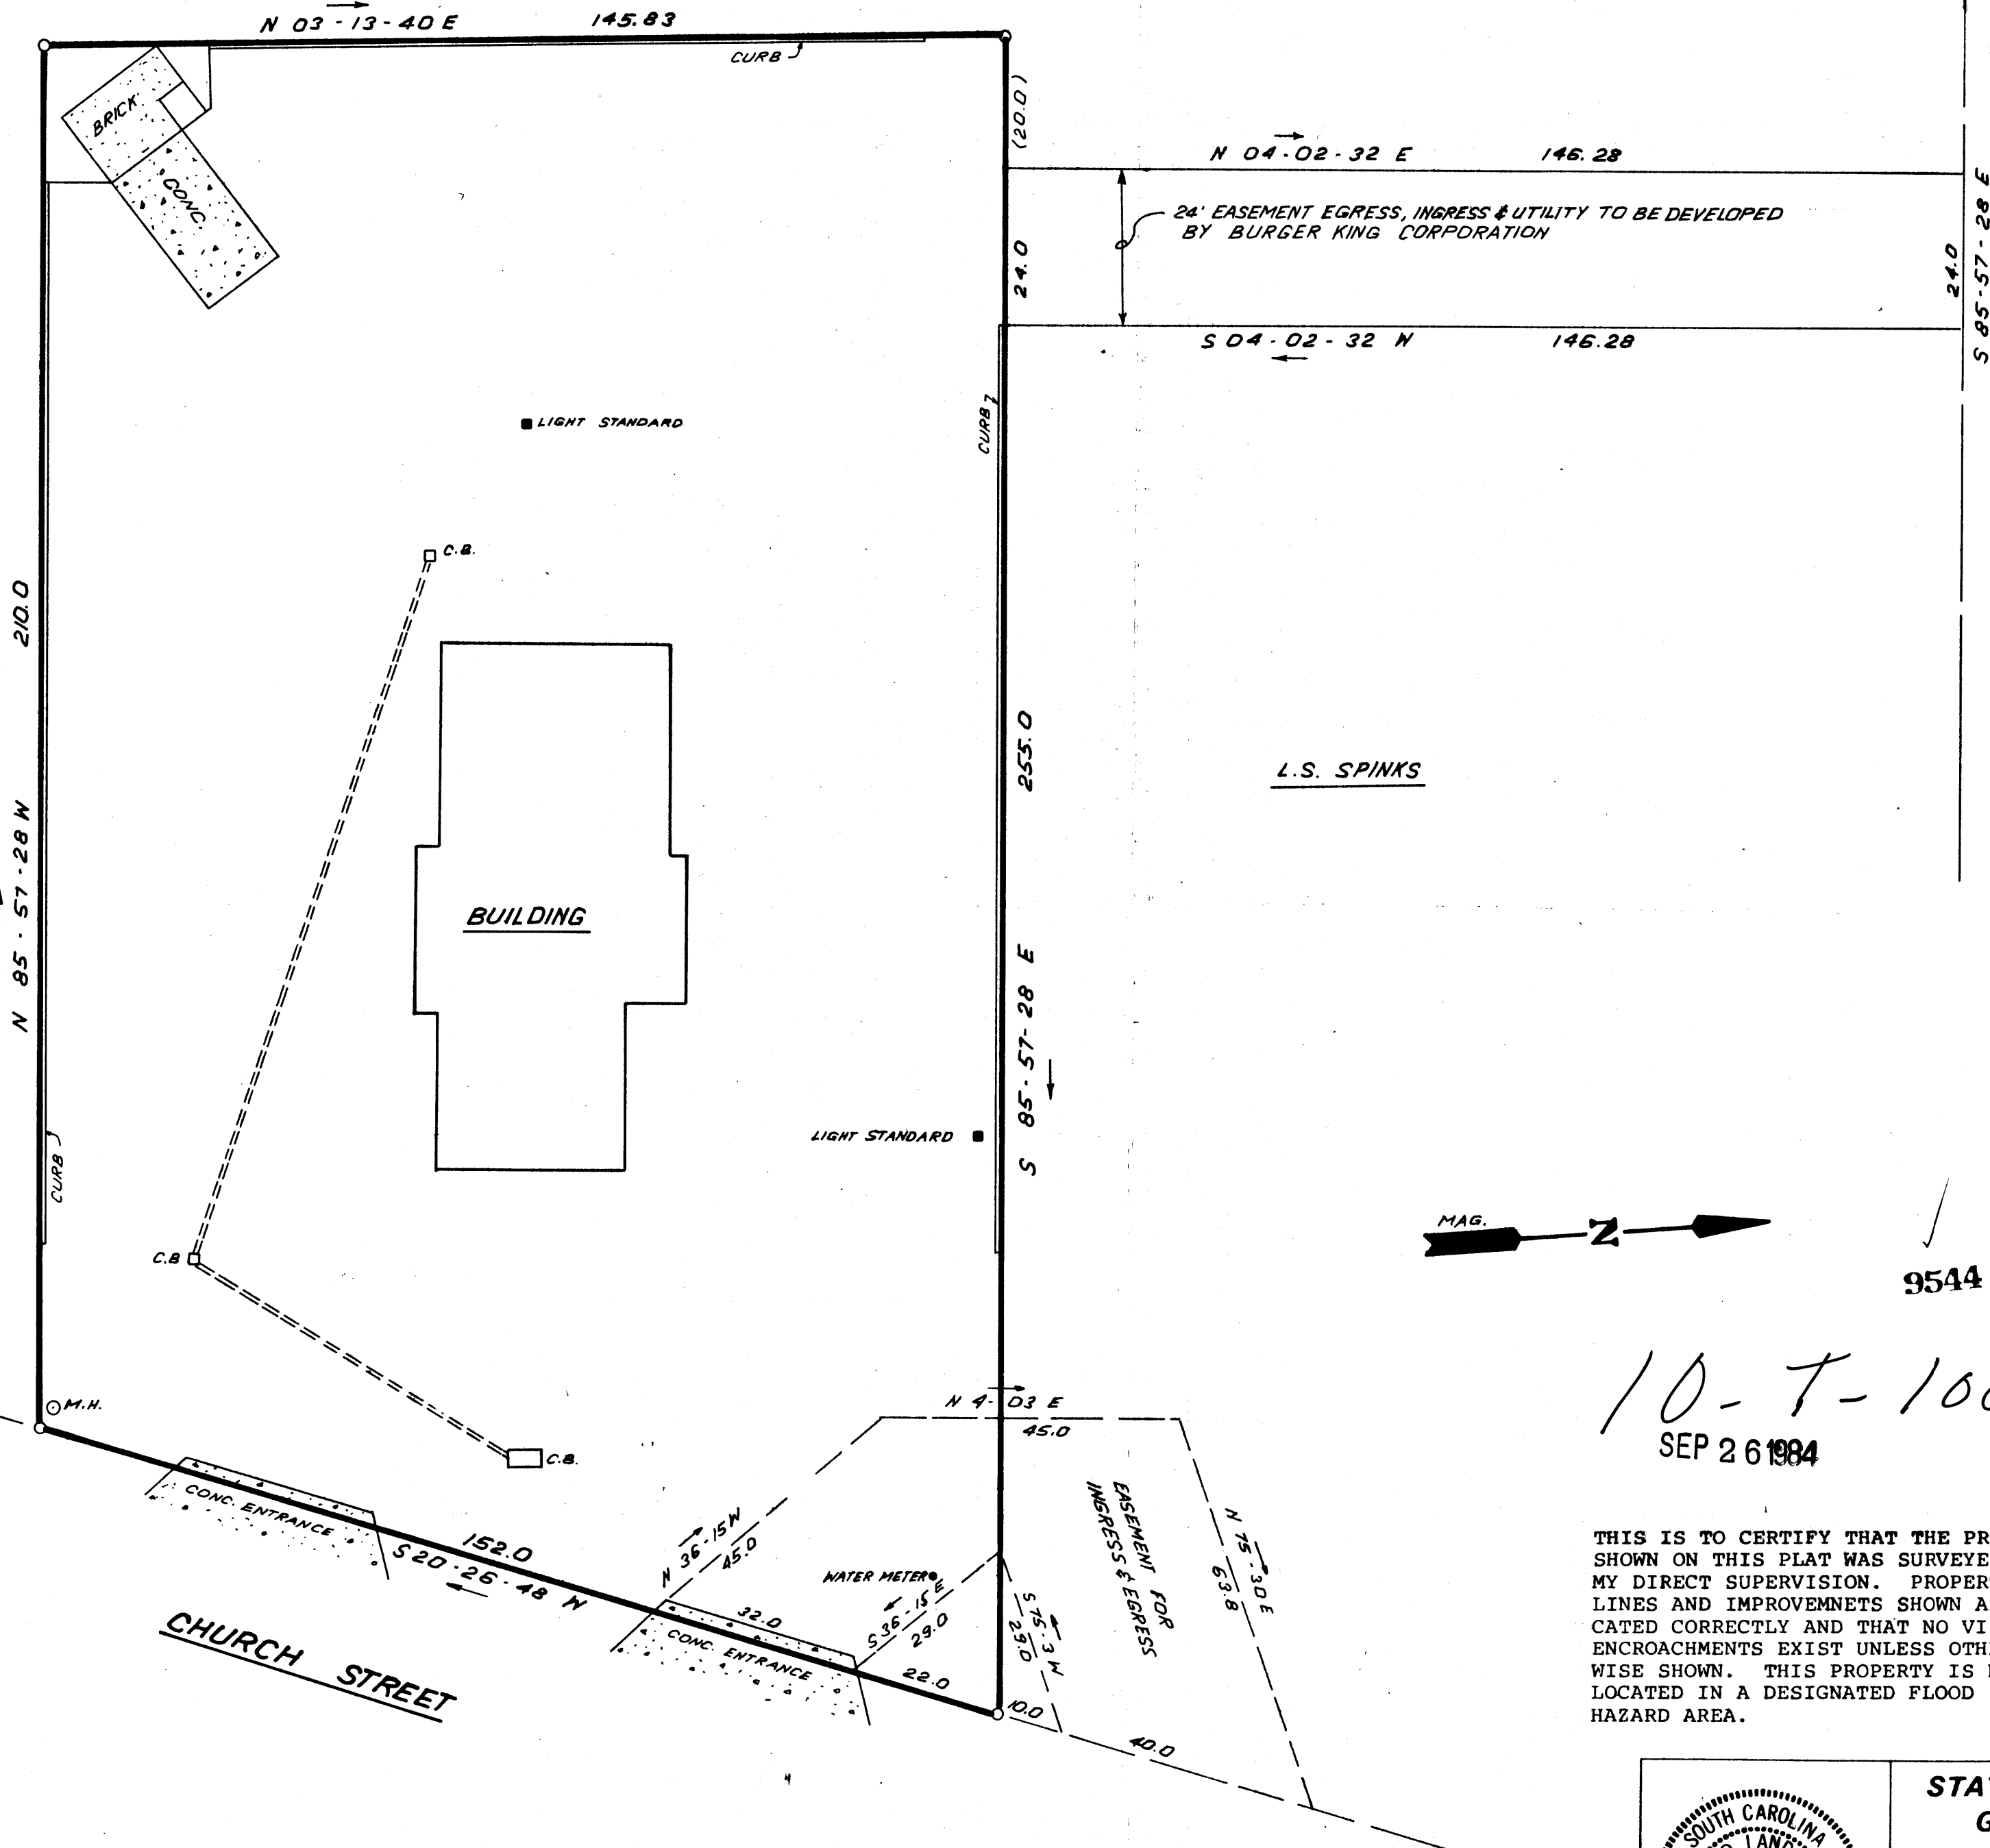

10-T-100  
SEP 26 1984

THIS IS TO CERTIFY THAT THE PROPERTY SHOWN ON THIS PLAT WAS SURVEYED UNDER MY DIRECT SUPERVISION. PROPERTY LINES AND IMPROVEMNETS SHOWN ARE LOCATED CORRECTLY AND THAT NO VISIBLE ENCROACHMENTS EXIST UNLESS OTHERWISE SHOWN. THIS PROPERTY IS NOT LOCATED IN A DESIGNATED FLOOD HAZARD AREA.

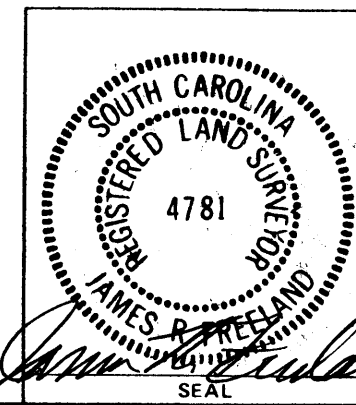


STATE OF SOUTH CAROLINA  
GREENVILLE COUNTY

SURVEY FOR  
LDS, INC.

FRELAND & ASSOCIATES  
Engineers • Land Surveyors  
GREENVILLE, S.C.

SURVEY	M.L.C.
DRAWN	Z.R.
CHECK	M.C.C.
SCALE	1" = 20'
DATE	9-21-84
DWG. NO.	11794

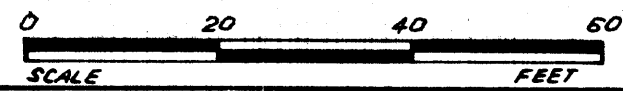

THE PRINT MACHINE, INC. N43337