

FILED
GREENVILLE CO. S.C.

JUL 9 3 51 PM '84

DONNIE S. TANKERSLEY
R.M.C.



I certify that I have surveyed this tract and that it is, to the best of my knowledge, as shown; that there are no encroachments; and that the tract does not lie in a flood plain.

Keith T. Gould
Keith T. Gould / S.C. Reg. S. #4085

Property of Cohen-Satterfield

S 71°-08' E
294.9' (TOTAL)

WOODED


OPEN FIELD

S 29°-56' W
513.30' (TOTAL)

O.I.P. @ 17'

O.I.P.

Nail & bottle cap

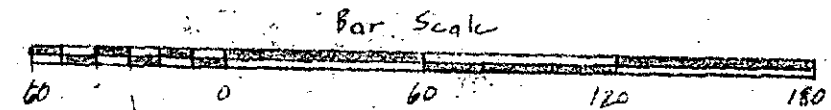

JUL 9 1984

former prop. of Earl R. McCall

10-4-2

Property of
IRENE M. WOOD

SCALE: 1" = 60'

APPROVED BY

DRAWN BY K.T.G.

DATE: 6-5-84

Tract area = 3 1/2 acres

BLK. BK. 531-2
Butler Township, Greenville County, West of Pelham, SC

K.T. Gould, Inc.

3-JUL-84 10:07 AM

DRAWING NUMBER

75-000D

Nails at all points in roads; I.P.'s as shown
Bldg. & utilities located as shown; no sewer.

WELL & SEPTIC TANK