MICROFILMED

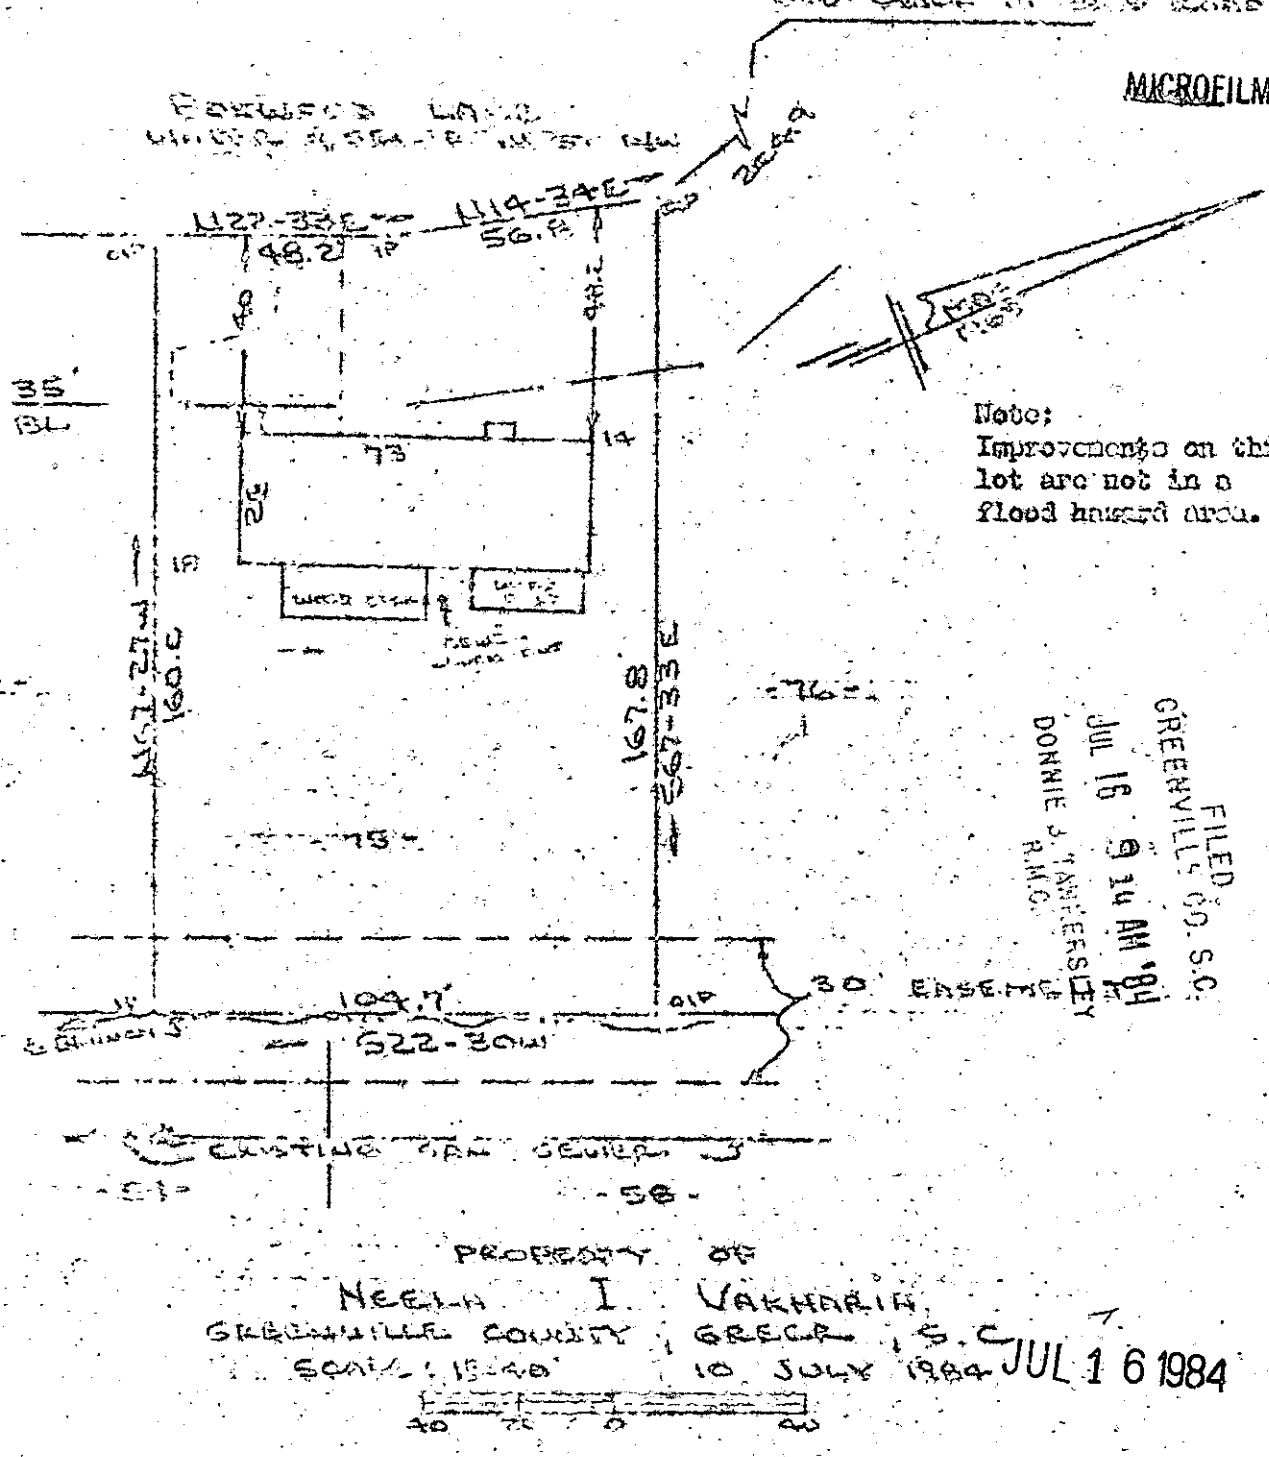

FILED
GREENVILLE CO. S.C.
JUL 16 9 14 AM '84
DONNIE S. TANKERSLEY
R.M.C.

JUL 16 1984

This is to certify that on the 10th day of July, 1984, I surveyed the property shown on this plat, being known as lot 75 on plat of KING ACRES and recorded in the RMC OFFICE Greenville County, S. C., in Plat Book " YY " at Page 153 and also being known as PROPERTY OF NEELA I. VAKHARIA and recorded in Plat Book at Page and that the property lines, walls and buildings are as shown hereon, and that the walls and buildings located on said lot do not encroach or project on adjacent piece of property, and that no adjacent walls or buildings encroach or project on said premises, and no power lines cross this property except as shown hereon.

1710

10-V-8

CAROLINA SURVEYING CO.
117 Mosby St.
Greenville, S. C.

R. B. Bruce PLS #4

Recordable Plat

3,00,8 21801.