


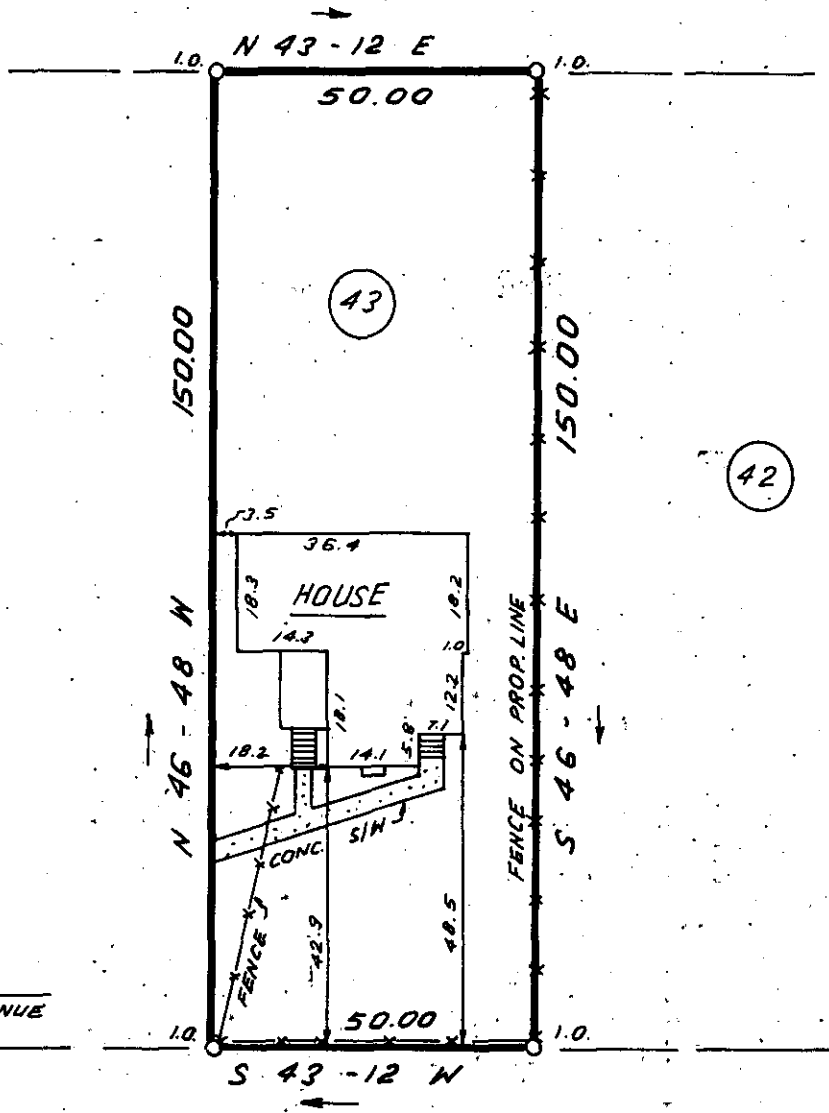

44


43

42



FILED  
 GREENVILLE CO., S.C.  
 JUL 20 3 29 PM '84  
 DONNIE S. TARKENSBLEY  
 R.M.C.

(CHARLES) BURGESS STREET JUL 20 1984

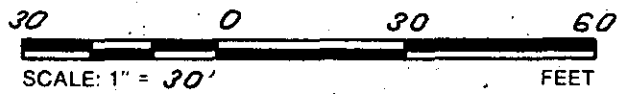

10-V-25 ✓ 2227

THIS IS TO CERTIFY THAT THE PROPERTY SHOWN ON THIS PLAT WAS SURVEYED UNDER MY DIRECT SUPERVISION. PROPERTY LINES AND IMPROVEMENTS SHOWN ARE LOCATED CORRECTLY AND THAT NO VISIBLE ENCROACHMENTS EXIST UNLESS OTHERWISE SHOWN. THIS PROPERTY IS NOT LOCATED IN A DESIGNATED FLOOD HAZARD AREA.

SOUTH CAROLINA  
 REGISTERED LAND SURVEYOR  
 4781  
 JAMES R. FREELAND  
 RLS: JAMES R. FREELAND  
 NO: 4781

STATE OF SOUTH CAROLINA  
 GREENVILLE COUNTY

NEWLANDS  
LOT 43  
 PROPERTY OF  
JERRY R. CRUMPTON  
CATHY S. CRUMPTON

FREELAND & ASSOCIATES  
 Engineers • Land Surveyors  
 318 WEST STONE AVENUE.  
 GREENVILLE, S.C.  
 (803) 271-4924

PLAT BOOK	C-199
DEED BOOK	1208-516
TAX MAP	158-2-20
PARTY CHIEF	B.C.
DRAWN	B.R.
DATE	4-12-84
DWG. NO.	10881

SC10 -- 1 JUL 20 84 943

3.00

MLC