


Magnetic

FILED  
GREENVILLE CO. S.C.  
AUG 2 10 38 AM '84  
DONNIE S. JANKERSLEY  
O.M.C.  
LOT 334

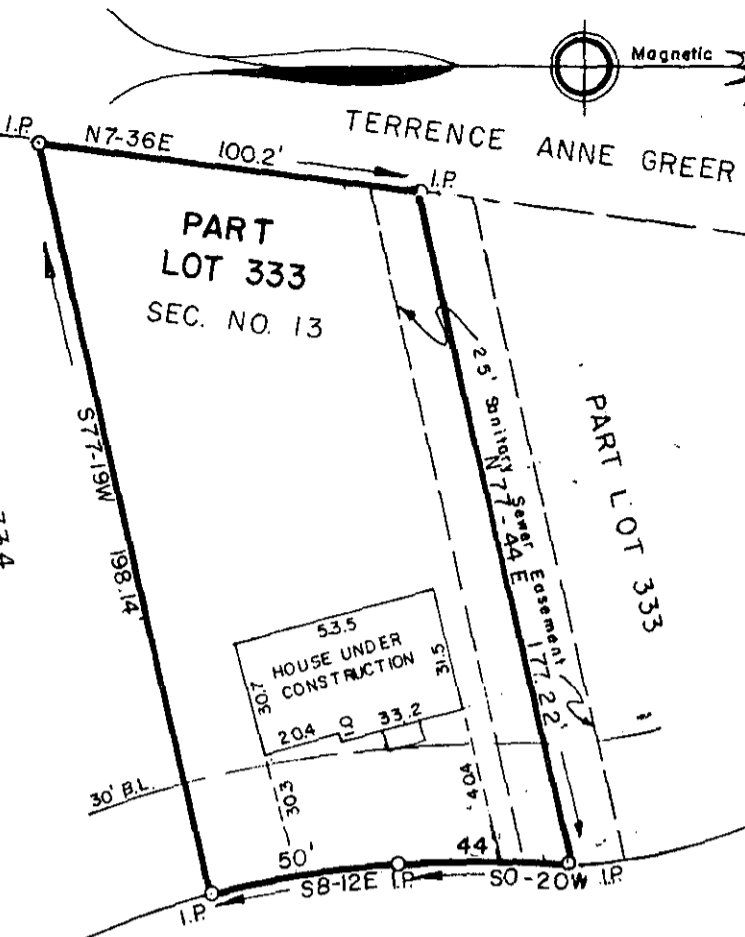

PROPERTY OF  
**BOB MAXWELL BUILDERS, INC.**


GREENVILLE CO., S.C.

Scale 1" = 50' July, 1984

This is to certify that on the 24th day of July, 1984, we surveyed the property shown on this plat being known as Part Lot 333 on plat of Devenger Place, Section Number 13, recorded in plat book 8-P, page 12, Office of R.M.C., Greenville County, S.C.; and that the property lines, walls and buildings are as shown hereon; and that the buildings located on said lot do not encroach or project on adjacent streets or property; and that no adjacent buildings or walls encroach or project on said premises; and from information from Greenville County, this structure is not in a designated flood area.

AUG 2 1984

10V-76

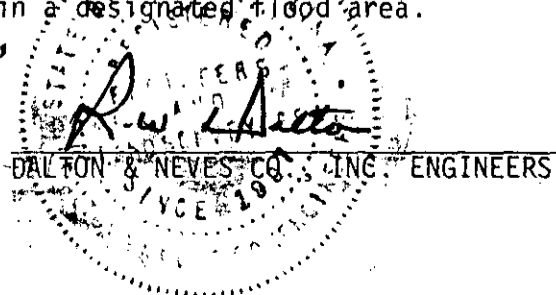

GREENVILLE CO. S.C. 2 AU 2 84 1122