


Note:
Improvements on
this lot are not
in a flood hazard
area.

PROPERTY OF
HARRY W. HAYNES
GREENVILLE COUNTY, GREENVILLE, S.C.
SCALE: 1" = 40' 2 AUG 1984

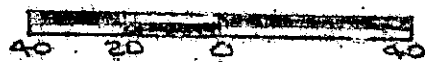

This is to certify that on the 2nd day of August, 1984, I surveyed the property shown on this plat, being known as lots 1 & 2 on plat of (UNKNOWN) PROPERTY OF UTOPIAN DEVELOPMENT CO. and recorded in the REC OFFICE Greenville County, S. C., in Plat Book " 11 " at Page 13 and also known as PROPERTY OF HARRY W. HAYNES and recorded in Plat Book " 3 " at Page 6; and that the property lines, walls and buildings are as shown hereon, and that the walls and buildings located on said lot do not encroach or project on adjacent street or property, and that no adjacent walls or buildings encroach or project on said premises, and no power lines cross this property except as shown hereon. Also known as PROPERTY OF HARRY W. HAYNES and recorded in Plat Book _____ at Page _____

R. B. Bruce
R. B. Bruce, SLS # 1952

DONNIE S. ANKERSLEY
AUG 7 12 17 PM '84
GREENVILLE COUNTY, S.C.
FILED

CAROLINA SURVEYING CO.
112 Hanly St.
Greenville, S. C.

4183

10-V-99

Recordable Plat