


THIS PLAT IS NOT A SUBDIVISION
AS DEFINED BY THE GREENVILLE
COUNTY SUBDIVISION REGULATIONS.

MICROFILMED

8.16.1984

John J. Winters
Chairman, Secretary, or Director of
Planning.
Greenville County Planning Commission

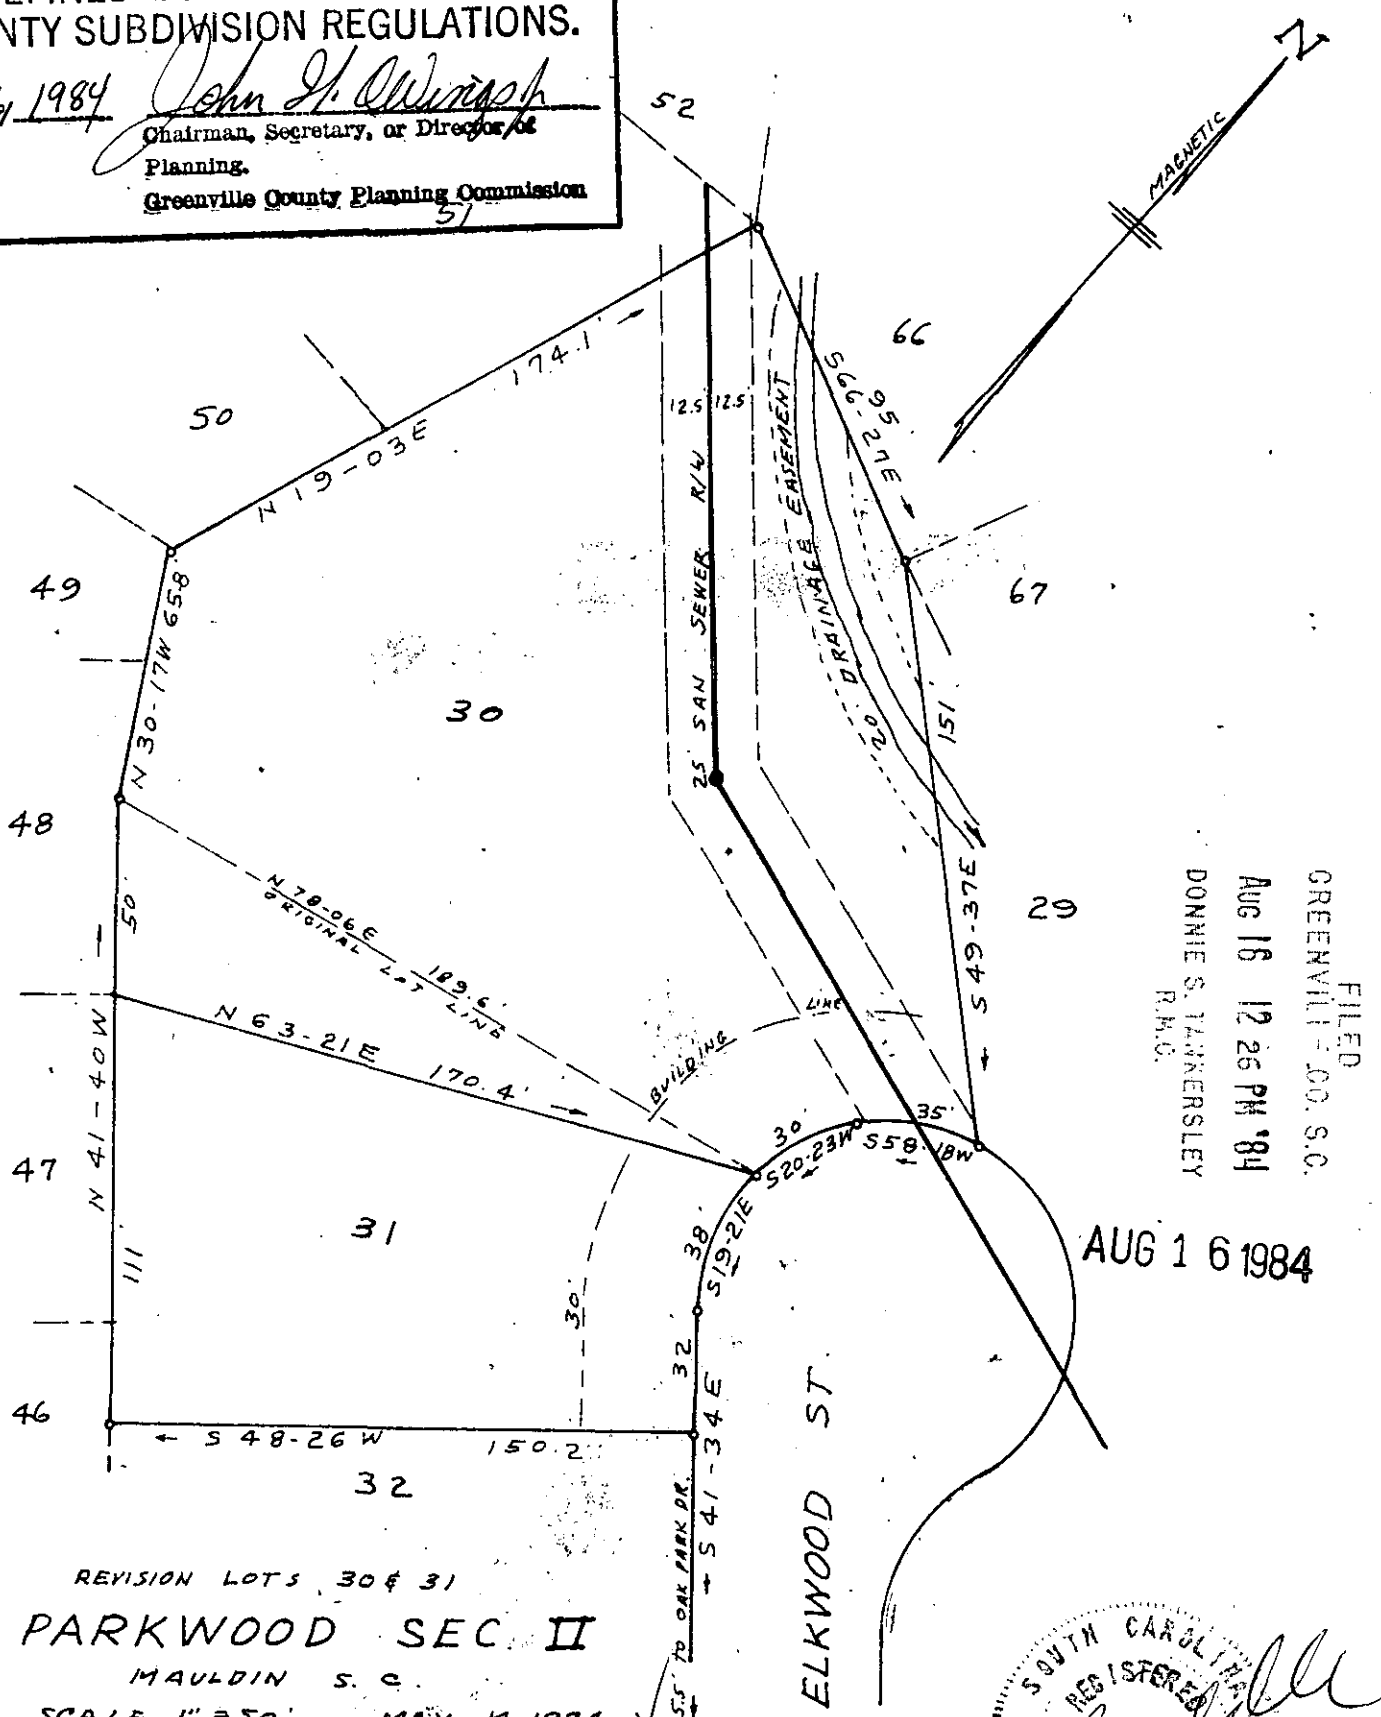

FILED
GREENVILLE CO. S.C.
AUG 16 12 26 PM '84
DONNIE S. TANKERSLEY
R.M.O.

AUG 16 1984

REVISION LOTS 30 & 31
PARKWOOD SEC II
MAULDIN S.C.
SCALE 1" = 50' MAY 14, 1974

10-W-18

5152

C. O. Riddette

C. O. RIDDETTE Reg. L.S. AUG 15 1984 Greenville, S.C. 3.0000



161-19C