
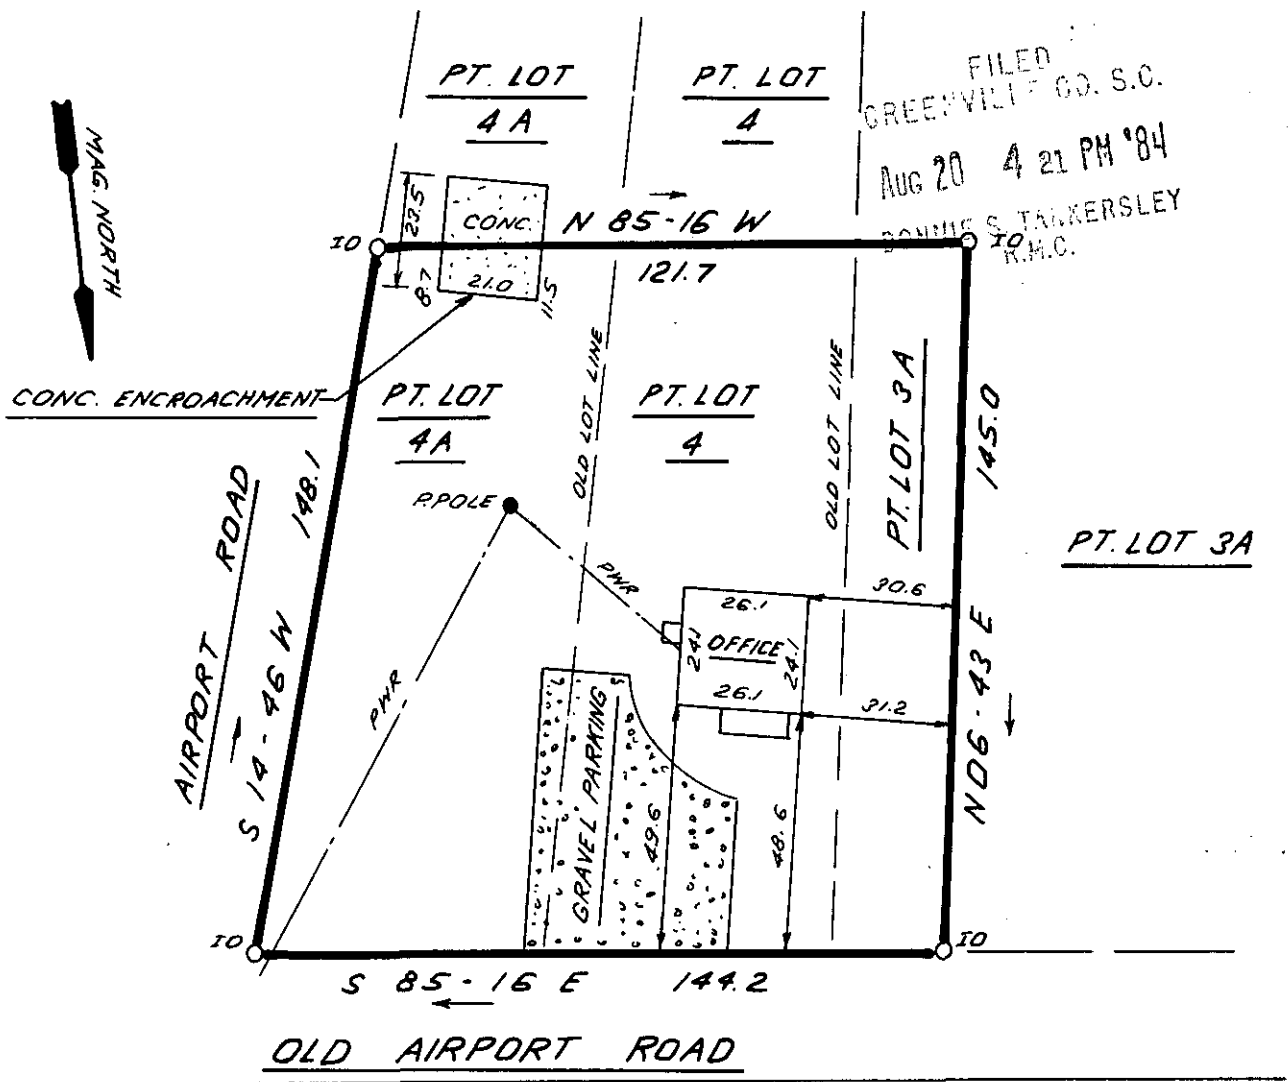


MICROFILMED

FILED
GREENVILLE CO. S.C.
AUG 20 4 21 PM '84
DONNIE S. TALKERSLEY
R.M.C.

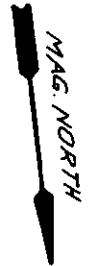

PT. LOT 3A

5466



10-W-31

THIS IS TO CERTIFY THAT THE PROPERTY SHOWN ON THIS PLAT WAS SURVEYED UNDER MY DIRECT SUPERVISION. PROPERTY LINES AND IMPROVEMENTS SHOWN ARE LOCATED CORRECTLY AND THAT NO VISIBLE ENCROACHMENTS EXIST UNLESS OTHERWISE SHOWN. THIS PROPERTY IS NOT LOCATED IN A DESIGNATED FLOOD HAZARD AREA.

**STATE OF SOUTH CAROLINA
GREENVILLE COUNTY**

FREELAND & ASSOCIATES
Engineers • Land Surveyors
318 WEST STONE AVENUE.
GREENVILLE, S.C.
(803) 271-4924

WALTER GOLDSMITH
PT. LOTS 4A, 4, & PT. LOT 3A
PROPERTY OF
MICHAEL J. SMITH

PLAT BOOK	8 H - 62
DEED BOOK	1148 - 569
TAX MAP	259-1-11,12
PARTY CHIEF	JC
DRAWN	I.R.
DATE	7-24-84
DWG. NO.	11524

James R. Freeland
S. JAMES R. FREELAND
NO: 4781

5070 2 AU20 94 1380 3.00CI