MICROFILMED

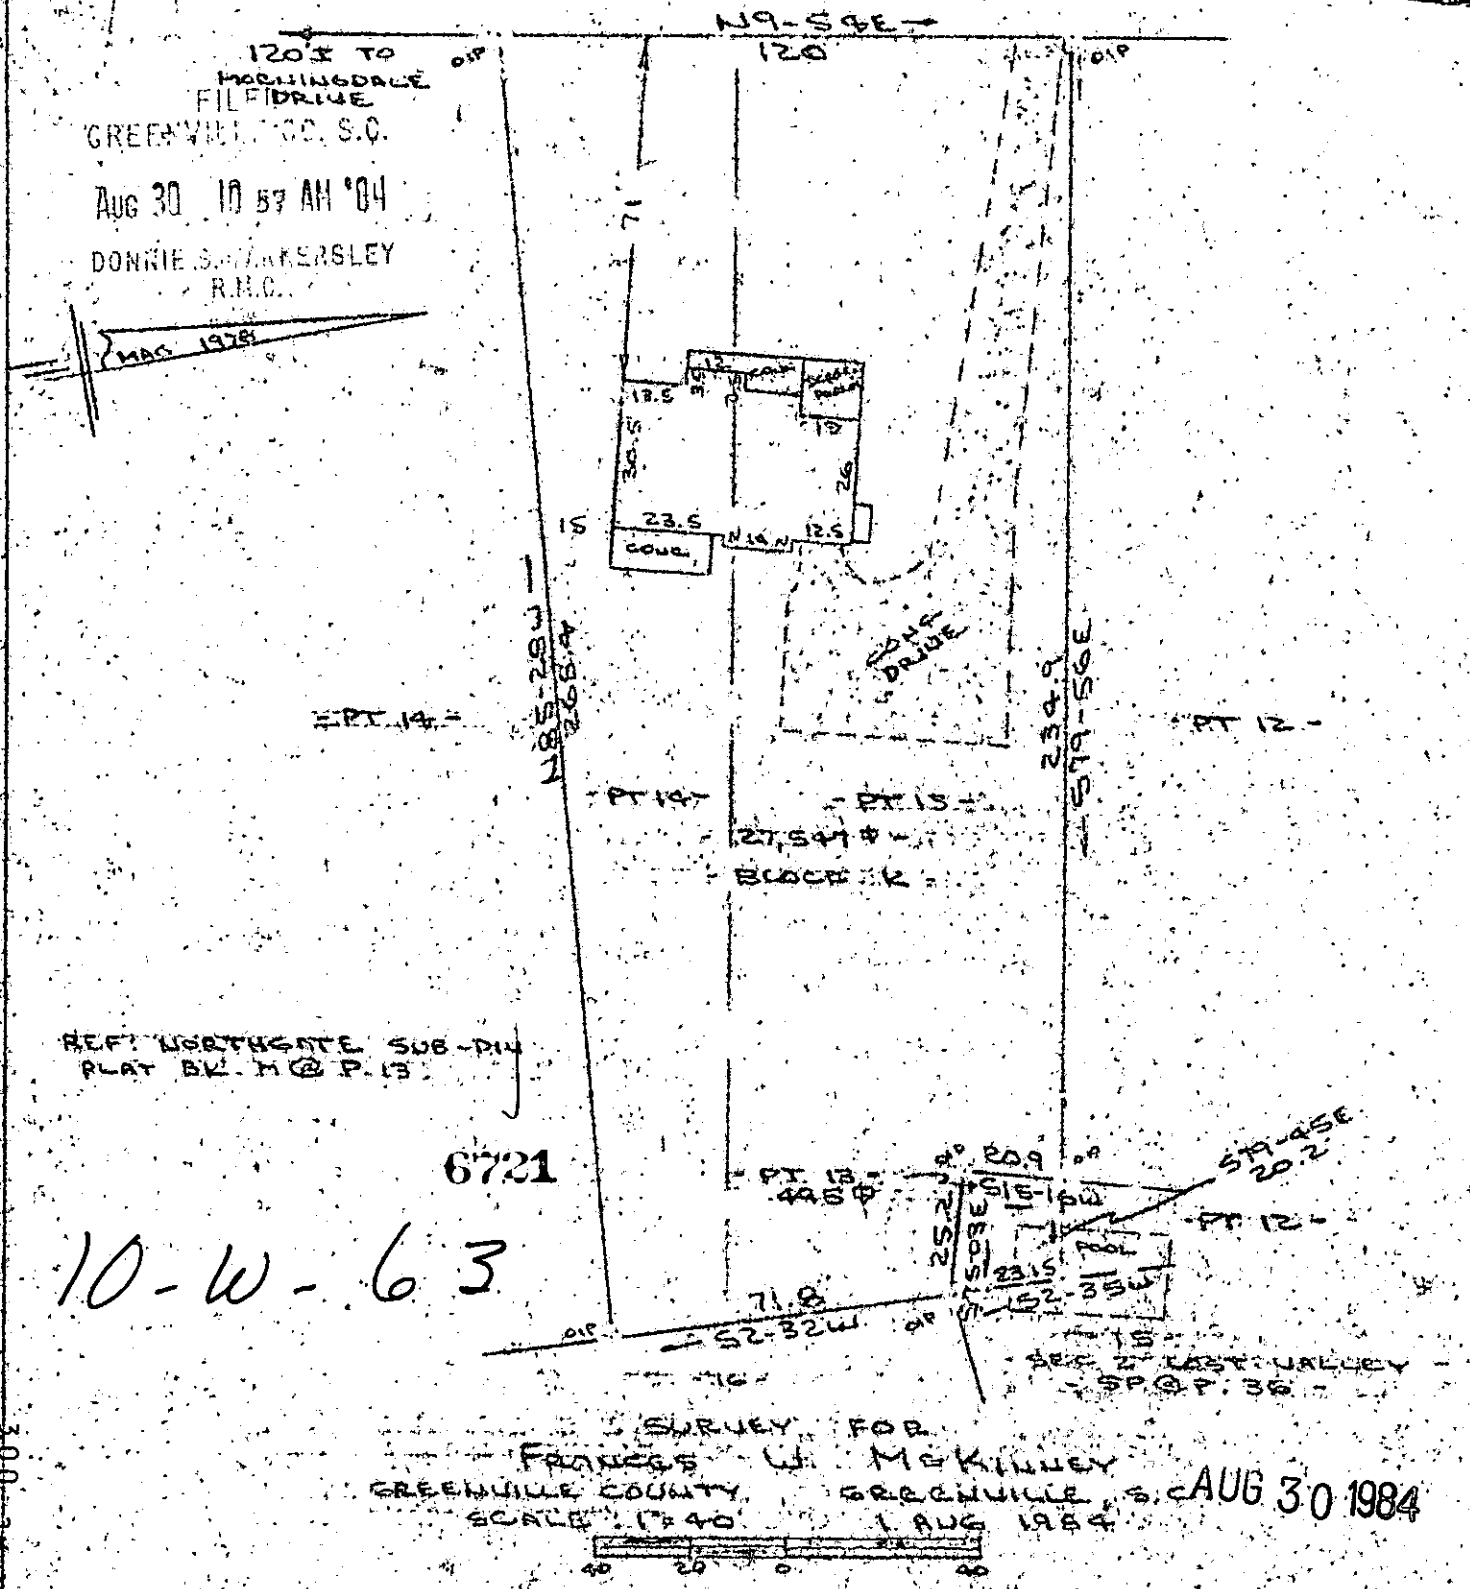

AUG 30 1984

I Certify That The Ratio Of Precision Of This Field Survey Is 1/10,000 As Shown Hereon And That The Area Determined By DMD Method Of Area Calculations.

R. B. Bruce RLS 1952

R. B. BRUCE RLS 1952

CAROLINA SURVEYING CO.
112 MAULDIN ST.
GREENVILLE, S.C.

Recordable Plat