


15

16

22

21

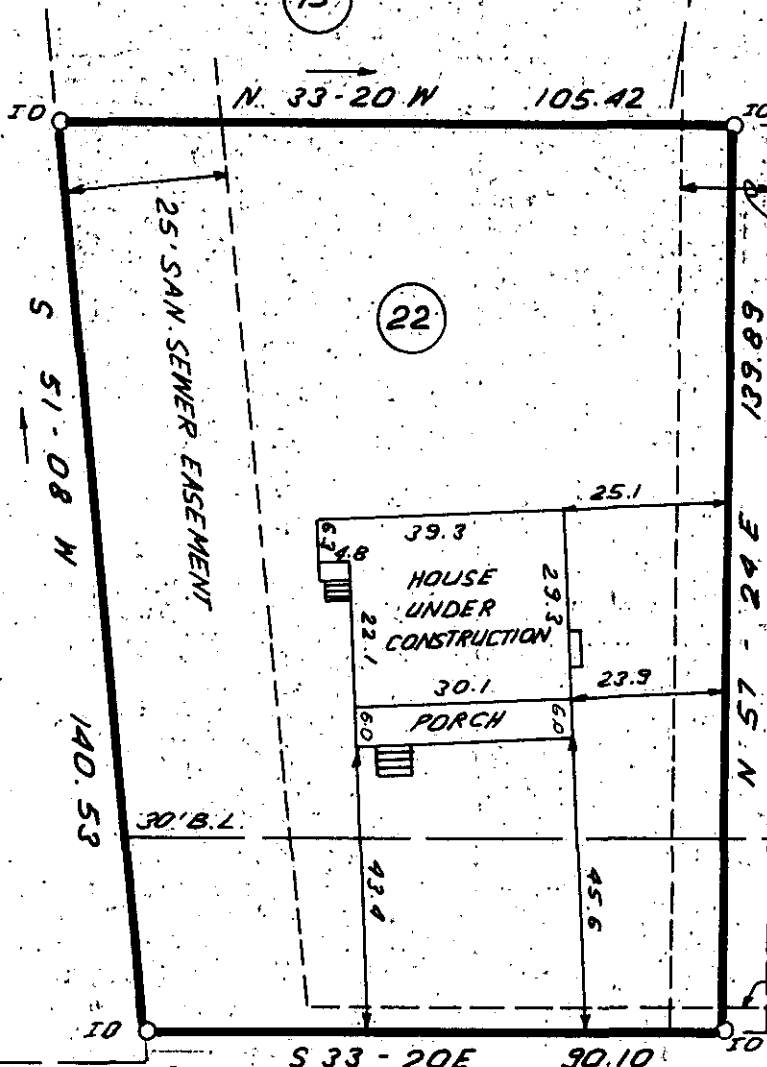

BETHEL CHURCH

FILED  
GREENVILLE CO. S.C.  
MAR 3 3 31 PM '84  
JIMMIE S. WALKER  
R.M.C.

150.33' ± TO  
BALCOMBE ROAD

HOLLAND ROAD

✓ 7257

10-W-71



NOTE: 5' DRAINAGE & UTILITY EASEMENT  
ALONG EACH SIDE OF ALL SIDE  
AND REAR LOT LINES.


THIS IS TO CERTIFY THAT THE PROPERTY SHOWN ON THIS PLAT WAS SURVEYED UNDER MY DIRECT SUPERVISION. PROPERTY LINES AND IMPROVEMENTS SHOWN ARE LOCATED CORRECTLY AND THAT NO VISIBLE ENCROACHMENTS EXIST UNLESS OTHERWISE SHOWN. THIS PROPERTY IS NOT LOCATED IN A DESIGNATED FLOOD HAZARD AREA.

STATE OF SOUTH CAROLINA  
GREENVILLE COUNTY

FREELAND & ASSOCIATES  
Engineers • Land Surveyors  
318 WEST STONE AVENUE  
GREENVILLE, S.C.  
(803) 271-4924

GILDER CREEK ESTATES  
PHASE I; LOT 22  
PROPERTY OF  
SAN DEL BUILDERS

|             |         |
|-------------|---------|
| PLAT BOOK   | 9W-68   |
| DEED BOOK   |         |
| TAX MAP     |         |
| PARTY CHIEF | R.J.    |
| DRAWN       | J.R.    |
| DATE        | 8-23-84 |
| DWG. NO.    | 11672   |

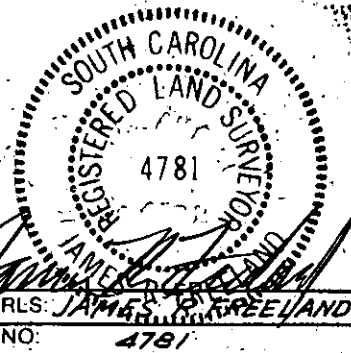

RLS: JAMES R. FREELAND  
NO: 4781

3.00  
1 SE 94 84 1057