



**Notes:**  
 Drainage & utility easements 5' either side of all side lot lines, and 10' on rear lot lines except as otherwise noted or shown.

**Note:** Improvements on this lot are not in a flood hazard area.

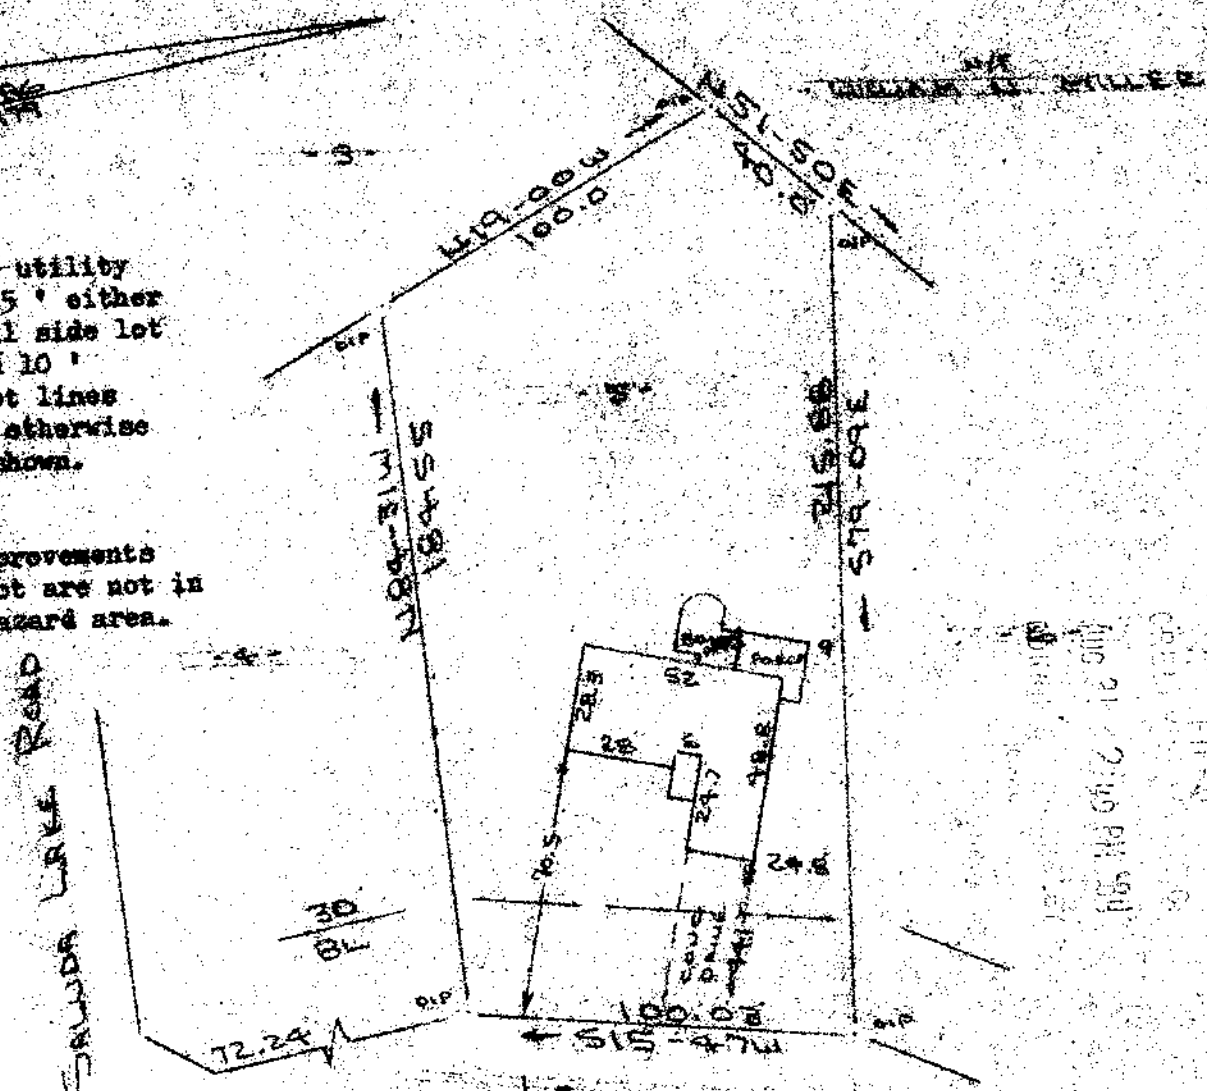

LENNARDT COURT  
 WATER & SEWER IN ST 2111

PROPERTY OF  
 DENNIS L. WHITE & JENNY B. WHITE  
 NEAR GREENVILLE, S.C.  
 SCALE: 1" = 80' 29 AUG 1984

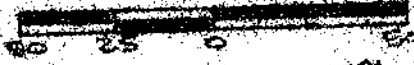

This is to certify that on the 29th day of August, 1984, I surveyed the property shown on this plat, being known as lot 5 on plat of WHITE OAK HILLS SUBDIVISION PHASE II - B (PROPERTY OF BOBBY J. JONES BUILDERS, INC.) and recorded in the RMC Office Greenville County, S. C., in Plat Book "8 - A" at Page 25; and that the property lines, walls and buildings are as shown hereon, and that the walls and buildings located on said lot do not encroach or project on adjacent street or property, and that no adjacent walls or buildings encroach or project on said premises, and no power lines cross this property except as shown hereon.

10-W-84 AUG 31 1984  
 6974

*R. B. Bruce*

CAROLINA SURVEYING CO.  
 112 Manly St.  
 Greenville, S. C.

R. B. Bruce, RLS # 1982  
**Recordable Plat**

100  
 21001