


FILED  
GREENVILLE CO. S.C.  
SEP 7 2 09 PM '84  
DUNNIE S. TANKERSLEY  
R.M.C.

3


2

1

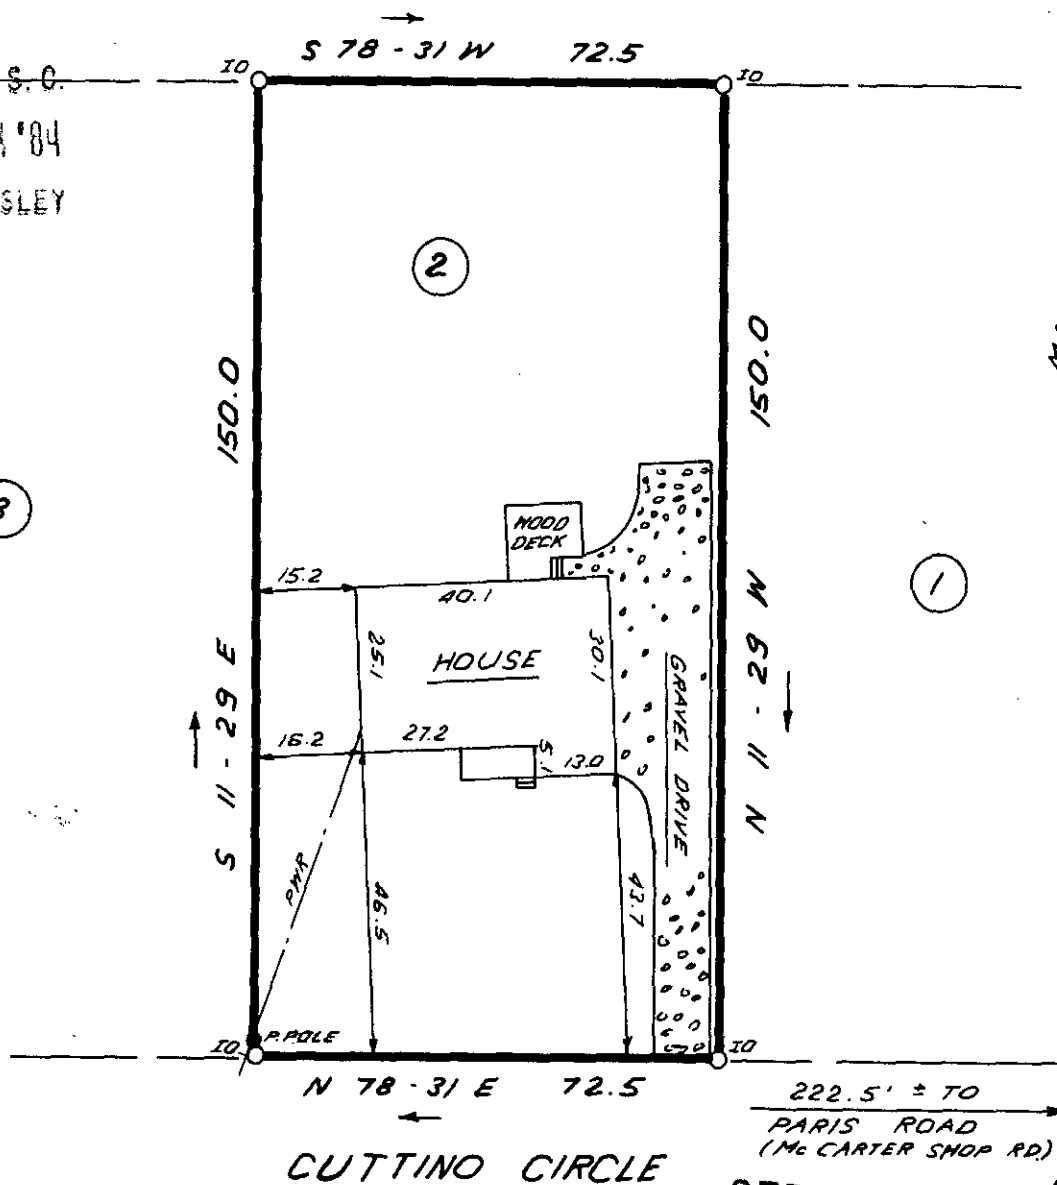

SEP 7 1984 ✓ 7683

10-W-98

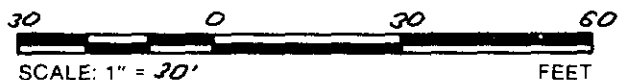

THIS IS TO CERTIFY THAT THE PROPERTY SHOWN ON THIS PLAT WAS SURVEYED UNDER MY DIRECT SUPERVISION. PROPERTY LINES AND IMPROVEMENTS SHOWN ARE LOCATED CORRECTLY AND THAT NO VISIBLE ENCROACHMENTS EXIST UNLESS OTHERWISE SHOWN. THIS PROPERTY IS NOT LOCATED IN A DESIGNATED FLOOD HAZARD AREA.

STATE OF SOUTH CAROLINA  
GREENVILLE COUNTY

FREELAND & ASSOCIATES  
Engineers • Land Surveyors  
318 WEST STONE AVENUE.  
GREENVILLE, S.C.  
(803) 271-4924

INEZ B. HALL PROP.  
LOT 2  
PROPERTY OF  
ALTON H. CAMPBELL, JR.  
TAMMY B. CAMPBELL

PLAT BOOK	FF 541
DEED BOOK	1149 - 71
TAX MAP	P 12-02-24
PARTY CHIEF	J.E.C.
DRAWN	I.R.
DATE	9-4-84
DWG. NO.	11717

