

FILED  
GREENVILLE CO. S.C.


OCT 12 2 16 PM '84

BONNIE S. TANKERSLEY  
R.M.C.

MAG.  
NORTH


BAILEY A TRAMMELL N/F

ELIZABETH  
S. BLAKELY  
N/F

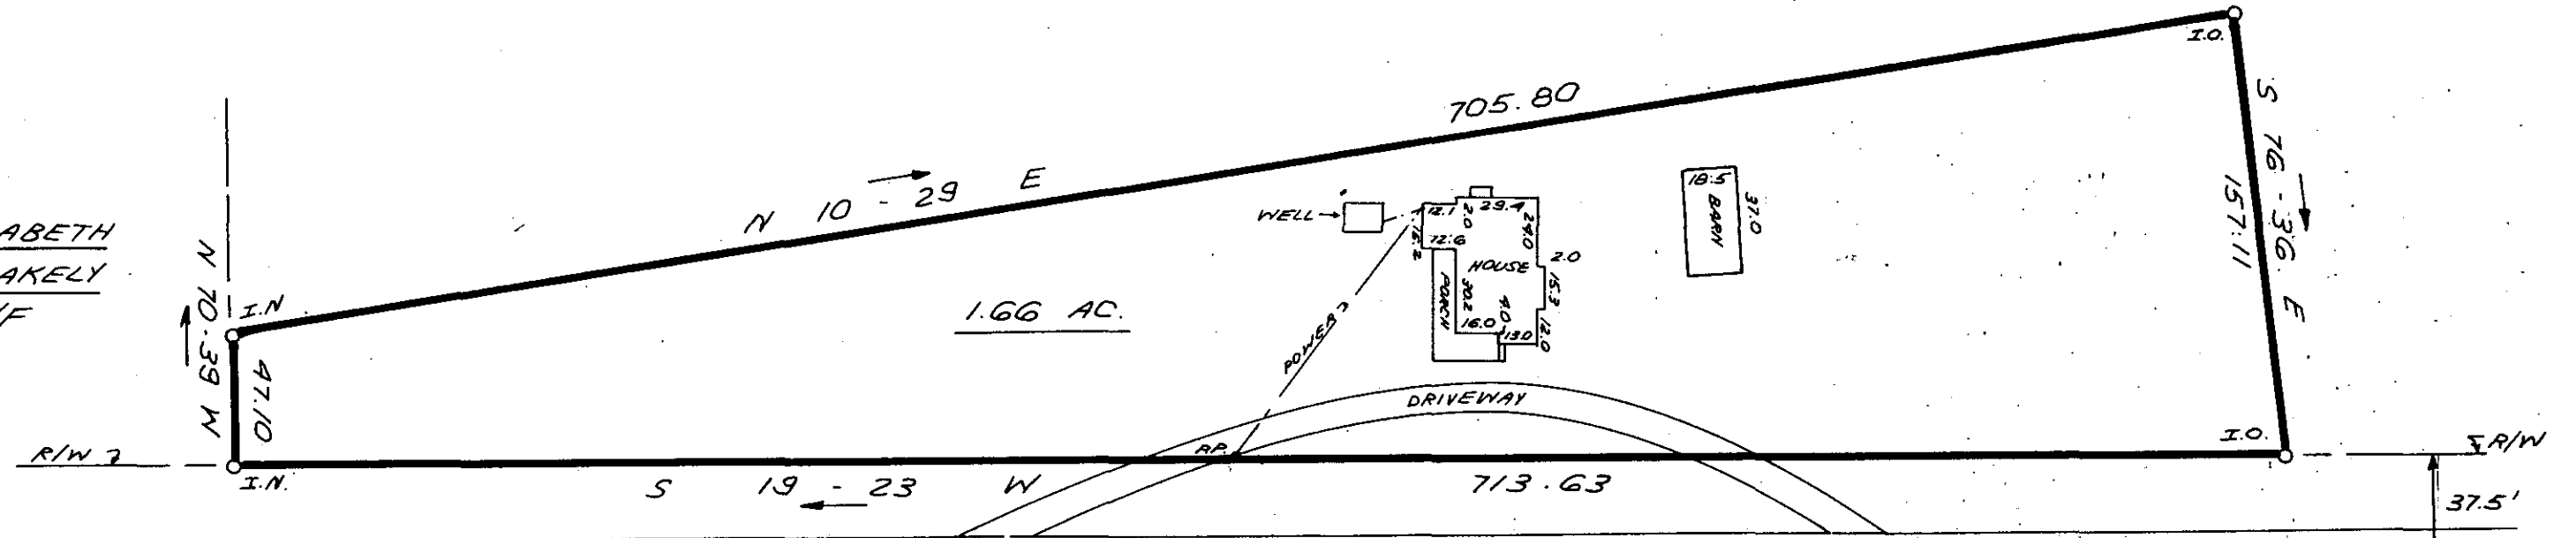

AUGUSTA ROAD - U.S. HWY # 25

SR BURGESS SCHOOL RD.

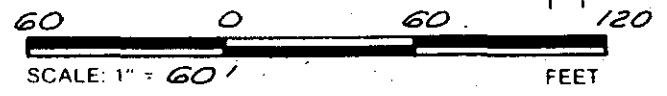


THIS IS TO CERTIFY THAT THE PROPERTY SHOWN ON THIS PLAT WAS SURVEYED UNDER MY DIRECT SUPERVISION. PROPERTY LINES AND IMPROVEMENTS SHOWN ARE LOCATED CORRECTLY AND THAT NO VISIBLE ENCROACHMENTS EXIST UNLESS OTHERWISE SHOWN. THIS PROPERTY IS NOT LOCATED IN A DESIGNATED FLOOD HAZARD AREA.

11213

10-X-51

OCT 12 1984

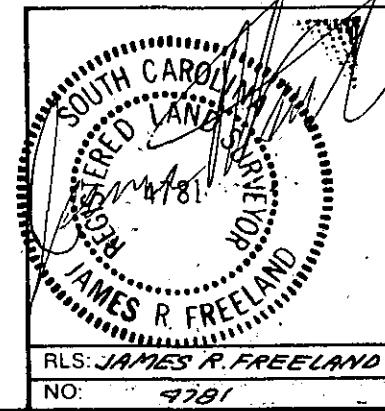

**STATE OF SOUTH CAROLINA  
GREENVILLE COUNTY**

SURVEY FOR  
GEORGE D. HANSON  
CARDLYN T. HANSON

**FREELAND & ASSOCIATES**  
Engineers • Land Surveyors  
318 WEST STONE AVENUE.  
GREENVILLE, S.C.  
(803) 271-4924

PLAT BOOK	
DEED BOOK	318-570
TAX MAP	604.3-1-2
PARTY CHIEF	J.D.
DRAWN	K.E.G.
DATE	SEPT. 19, 1984
DWG. NO.	11767

THE PRINT MACHINE, INC. 0 11128

MICROFILMED